

AS-BUILT RESIDENTIAL DEVELOPMENT

FOR

MR. ADEBAYO OLUWATOBI
ABIODUN

ON DUROSUSU FAMILY LAND
ALONG EGAN ROAD MOJODA ODO AYAN
EPE LOCAL GOVT AREA,
LAGOS STATE.

YUNGOLA SERVICES
LTD.


(ARCHITECTURAL DESIGN, STRUCTURAL DESIGN,
CONSULTANT, SUPERVISION)

ADDRESS:
NO 2 OSHOGBO STREET, OGUDU,
LAGOS STATE

TEL :
08054178584, 07062539641

DESIGN :
OCTOBER, 2024.

NOTE;

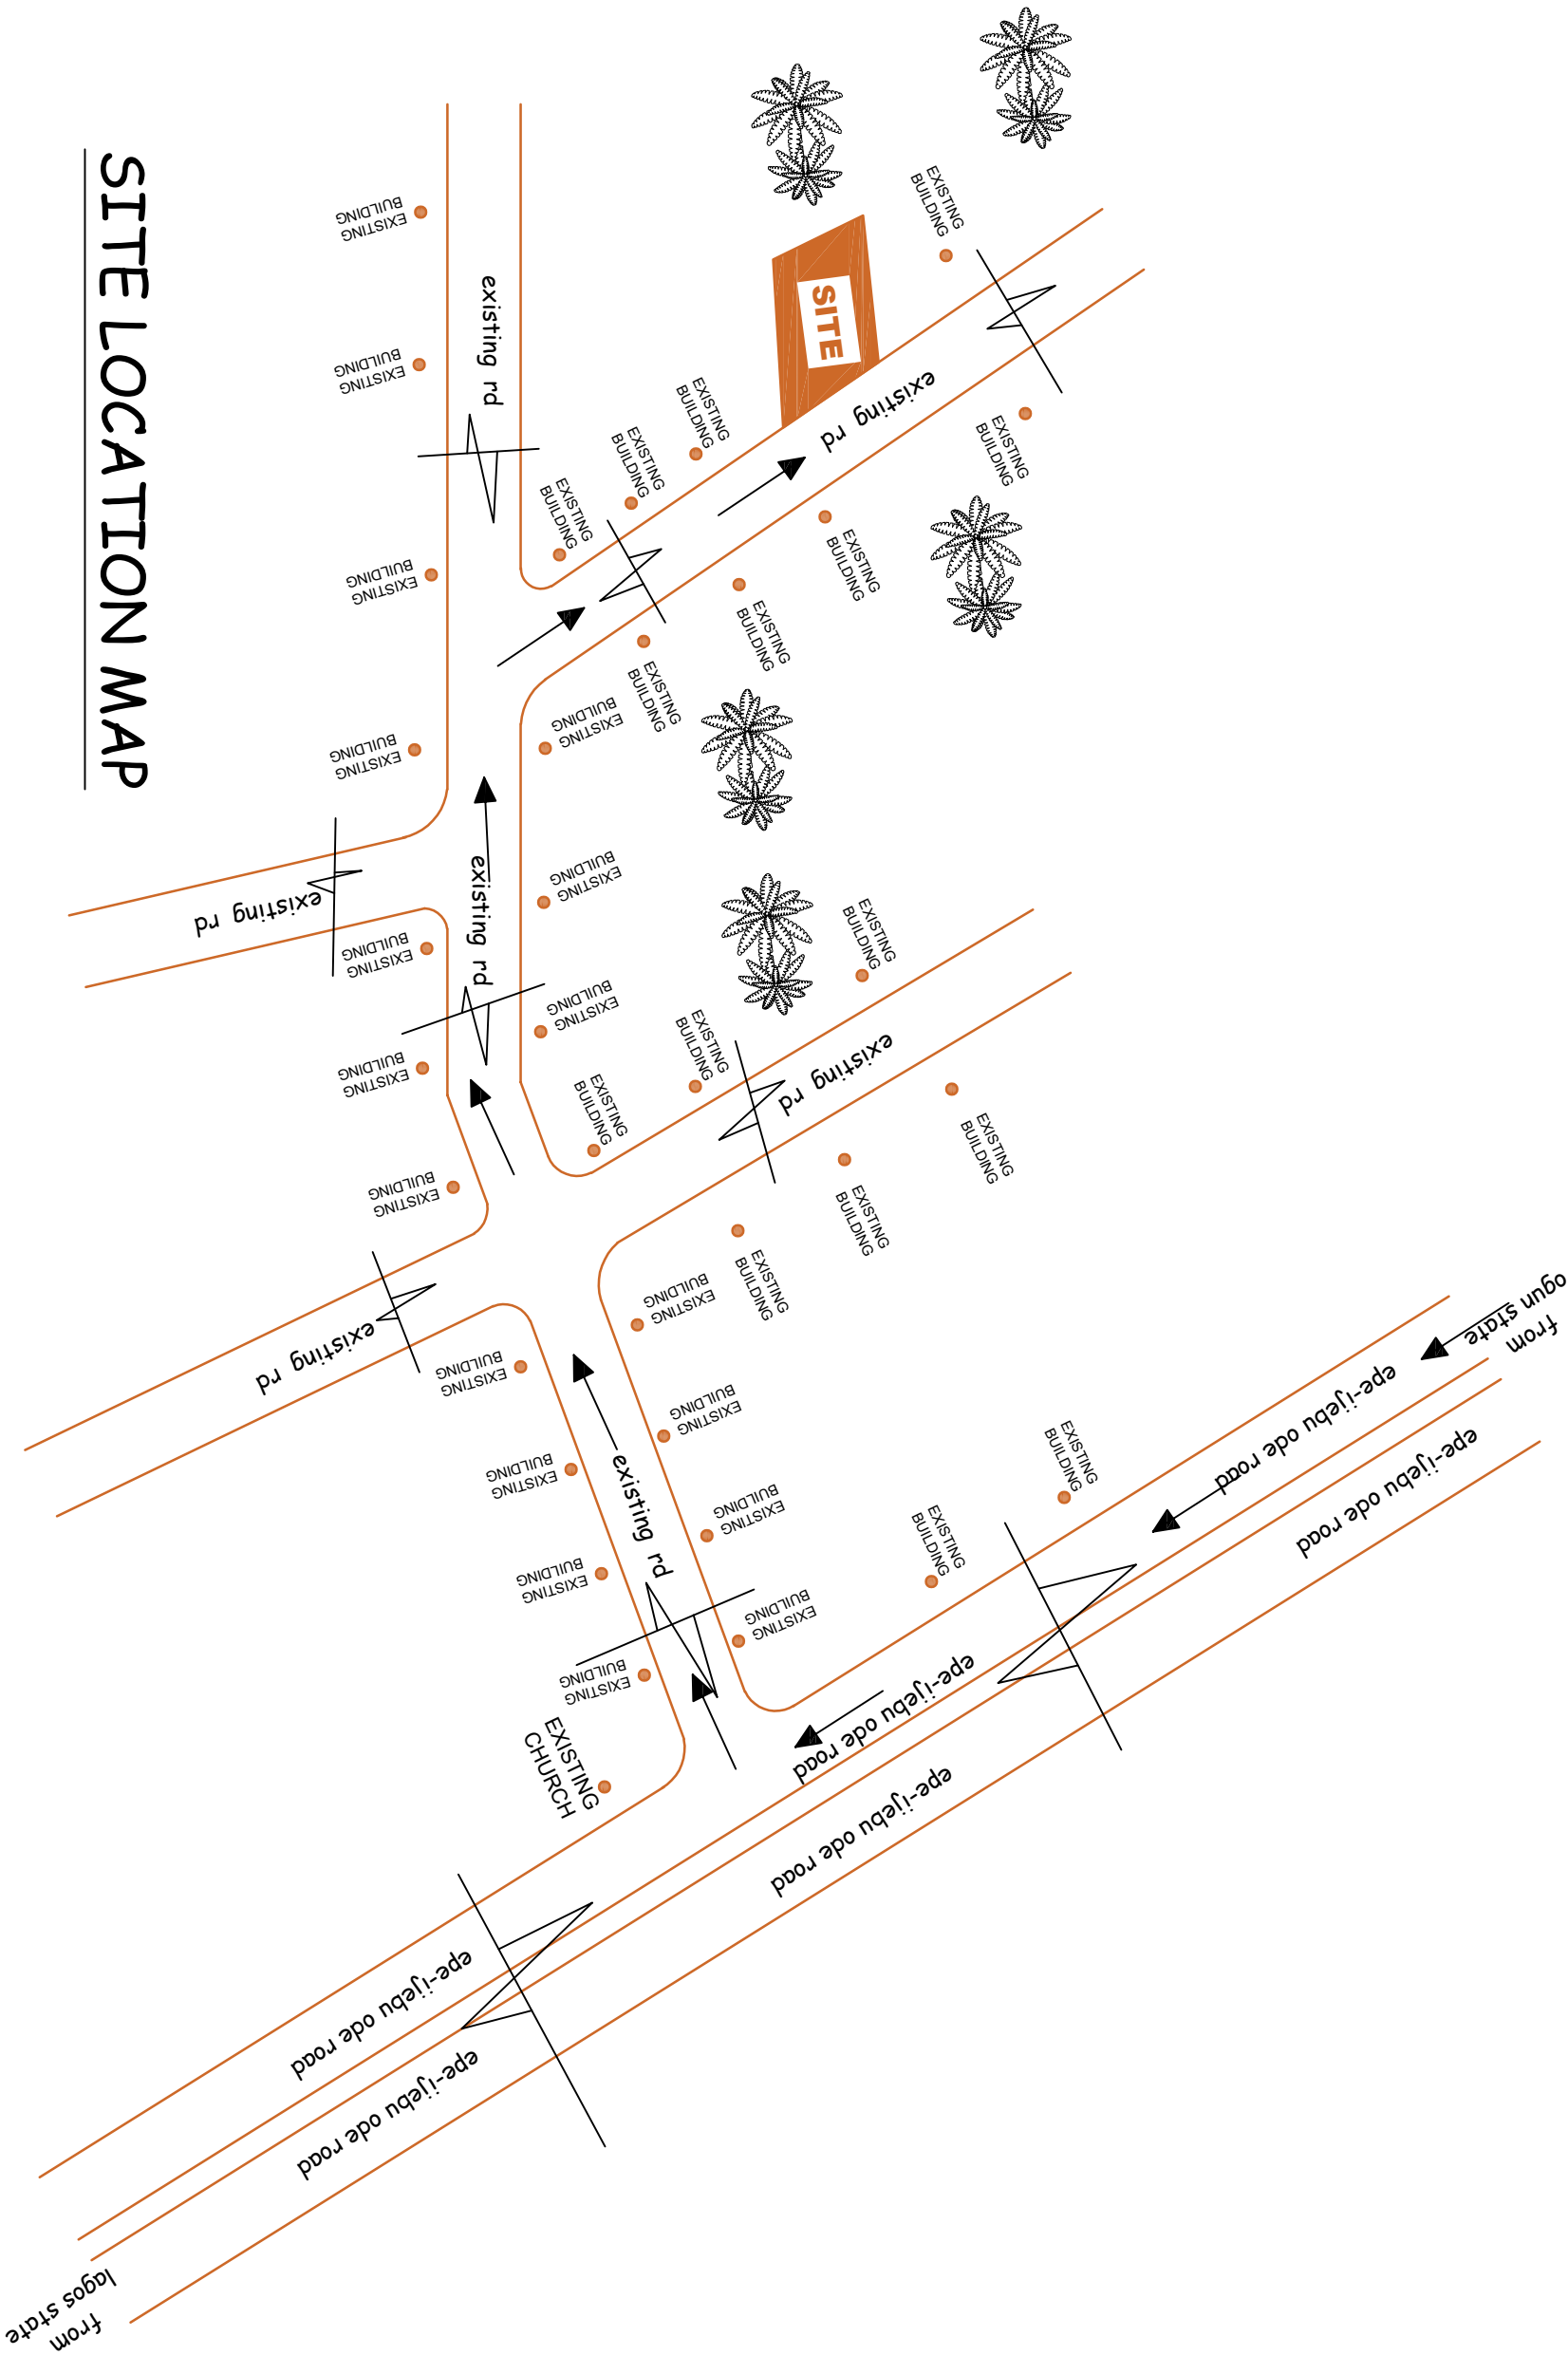

SITE LOCATION MAP

general note

- 1) The contractor is to check all the drawing before commencing work.
- 2) Any discrepancies observed on this drawing issued by any other party are to be immediately brought to consultant Architect Notice.
- 3) All dimension are in millimeter.
- 4) Dimension are to be confirmed on site.

Client :-

MR. ADEBAYO OLUWATOBI
ABIODUN

Location :-

ON DUKOSUSU FAMILY LAND
ALONG EGAN ROAD MOJODA ODO AYAN
EPE LOCAL GOVT AREA,
LAGOS STATE.

Project Title :-

**As-Built Residential
Development**

Approval
Drawing

Architect :-

**YUNGOLA SERVICES
LTD.**
(ARCHITECTURAL DESIGN, STRUCTURAL DESIGN,
CONSULTANT,SUPERVISION)

OFFICE ADDRESS:

NO 2 OSHOGBO STREET,
OGUDU
LAGOS STATE
☎ ; 08054178584, 07062539641

Office stamp

sheet
content:-

Plan

date :-

OCTOBER, 2024

sheet no :-

scale :-

1:100

revision :-


Drawn by :-

Yungola

Checked by :-

Oluwaseun

NOTE;

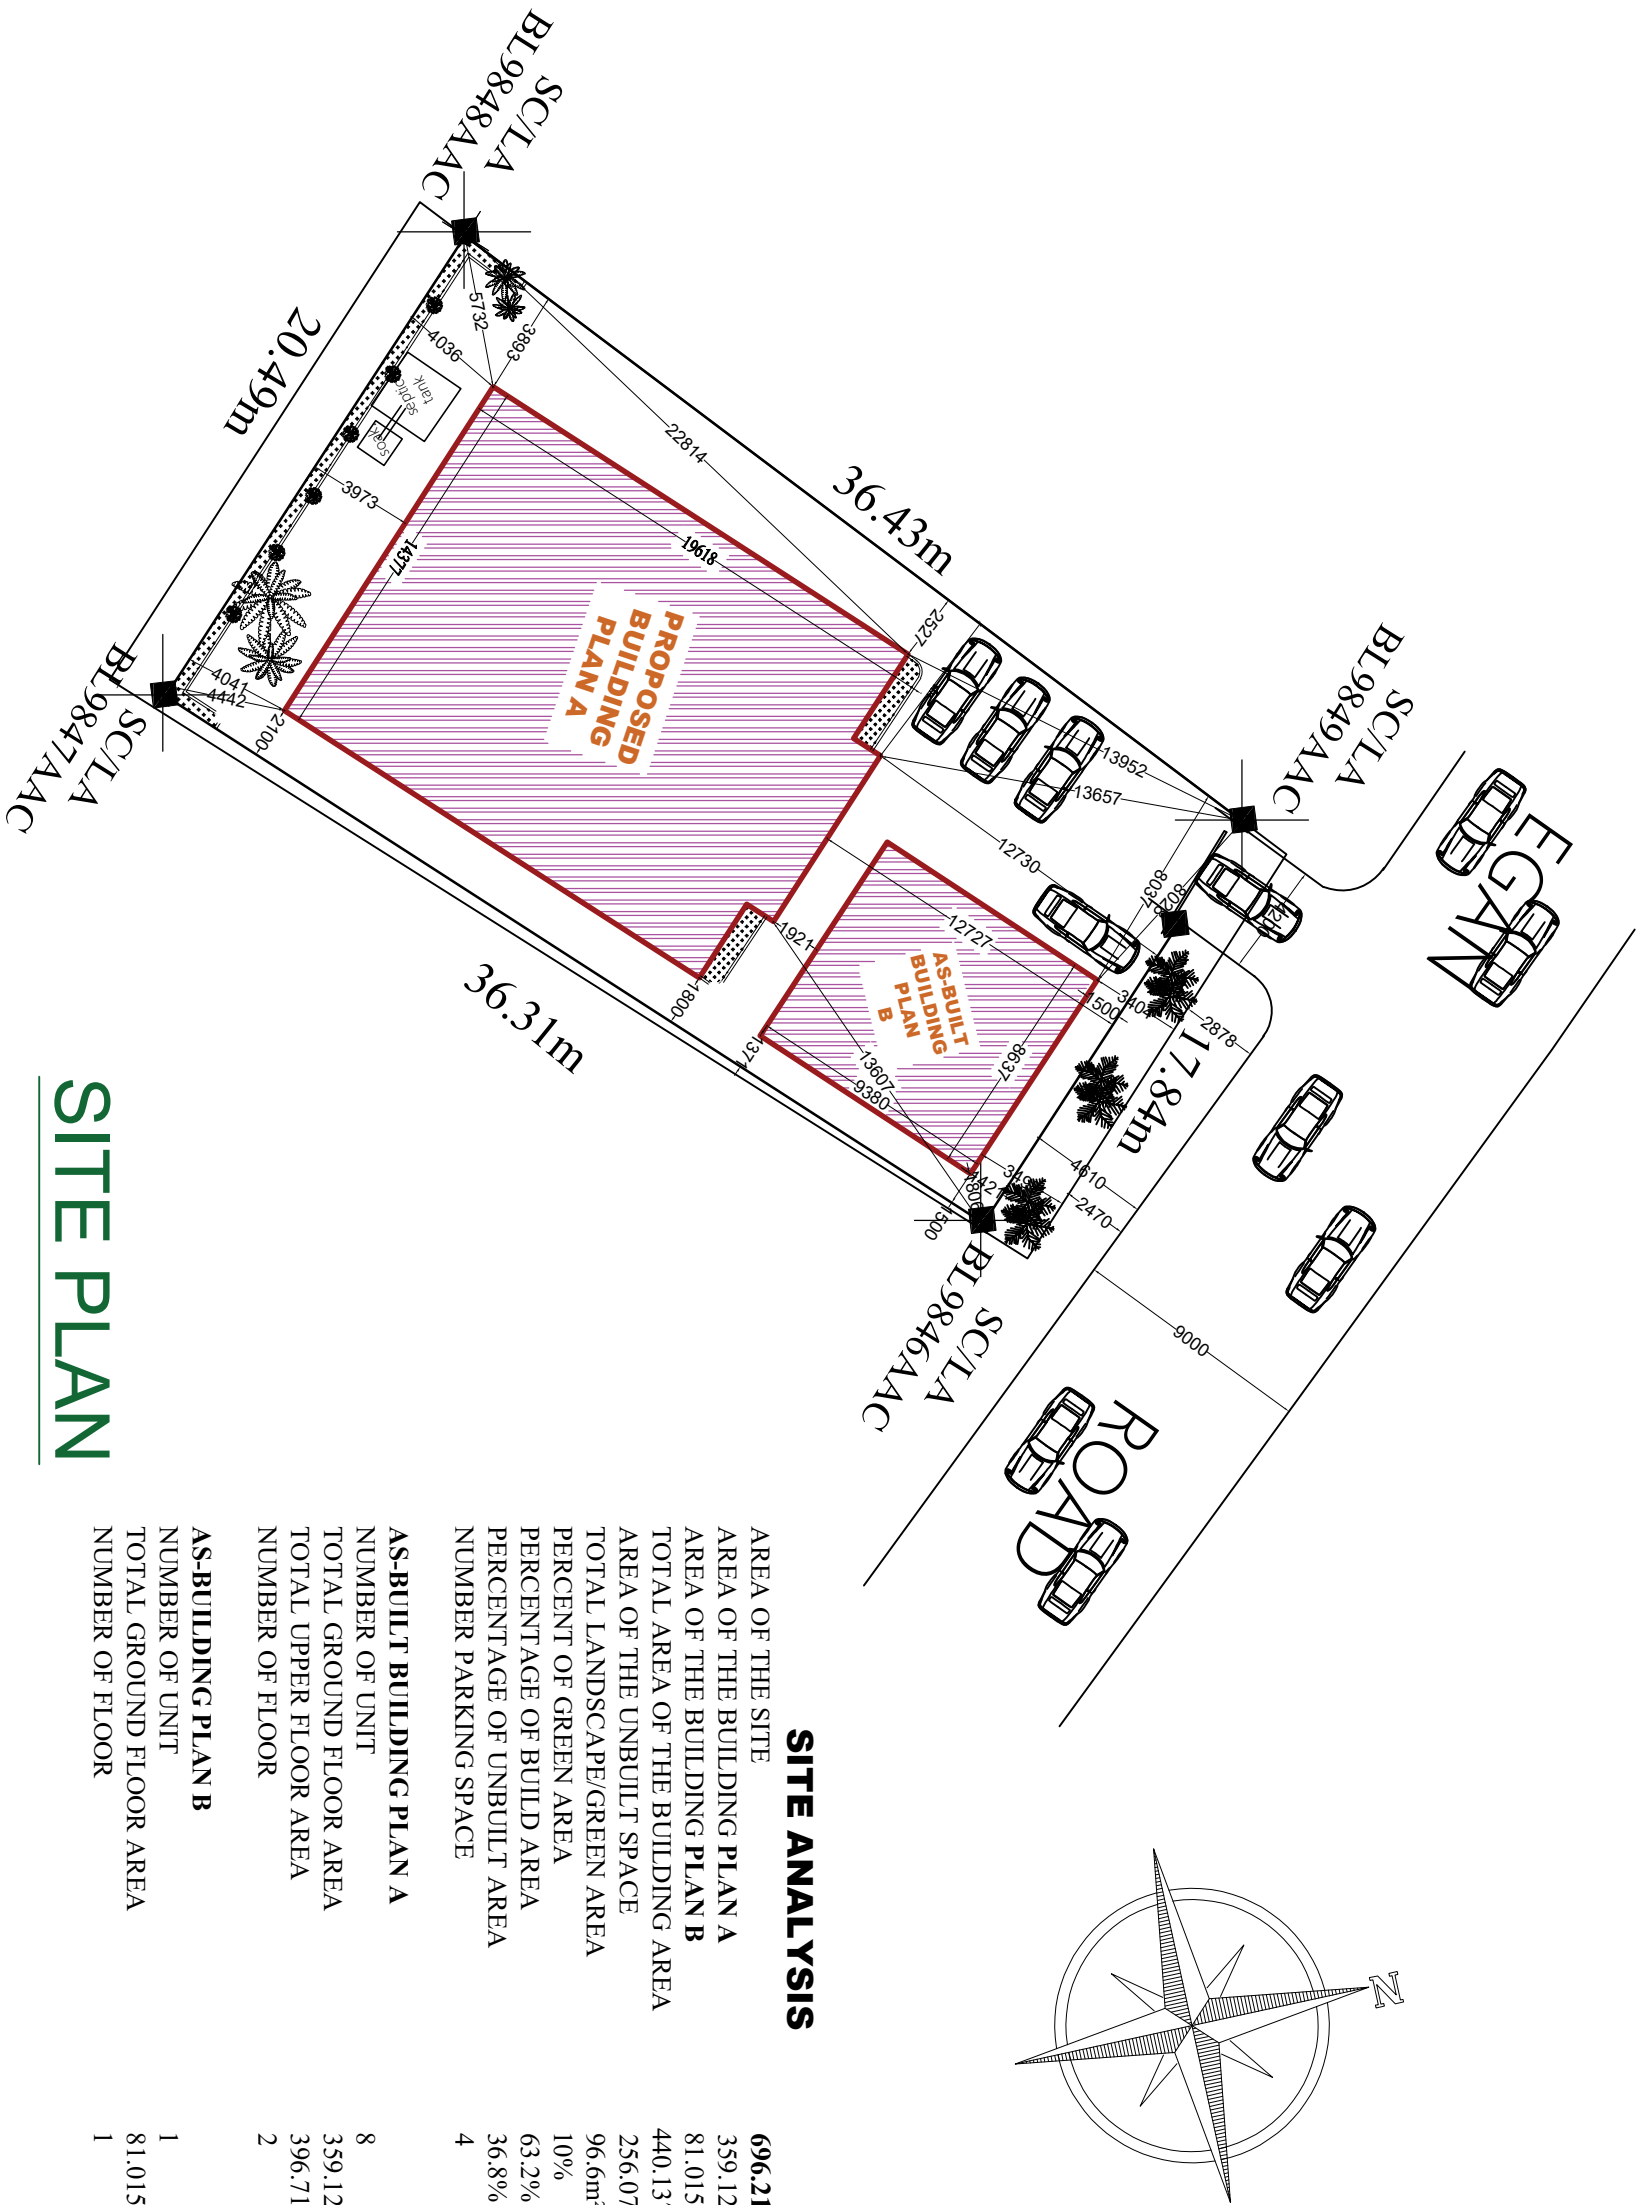

SITE ANALYSIS

AREA OF THE SITE	696.214m²
AREA OF THE BUILDING PLAN A	359.122m²
AREA OF THE BUILDING PLAN B	81.015m²
TOTAL AREA OF THE BUILDING AREA	440.137m²
AREA OF THE UNBUILT SPACE	256.077m²
TOTAL LANDSCAPE/GREEN AREA	96.6m²
PERCENTAGE OF GREEN AREA	10%
PERCENTAGE OF BUILD AREA	63.2%
PERCENTAGE OF UNBUILT AREA	36.8%
NUMBER PARKING SPACE	4
AS-BUILT BUILDING PLAN A	
NUMBER OF UNIT	8
TOTAL GROUND FLOOR AREA	359.122m²
TOTAL UPPER FLOOR AREA	396.715m²
NUMBER OF FLOOR	2
AS-BUILDING PLAN B	
NUMBER OF UNIT	1
TOTAL GROUND FLOOR AREA	81.015m²
NUMBER OF FLOOR	1

SITE PLAN

general note

- 1) The contractor is to check all the drawing before commencing work.
- 2) Any discrepancies observed on this drawing issued by any other party are to be immediately brought to consultant Architect Notice.
- 3) All dimension are in millimeter.
- 4) Dimension are to be confirmed on site.

Client :-

MR. ADEBAYO
OLUWATOBI ABIODUN

Location :-

ON DUKOSUSU FAMILY LAND
ALONG EGAN ROAD MOJODA ODO AYAN
EPE LOCAL GOVT AREA,
LAGOS STATE.

Project Title :-

As-Built Residential
Development

Architect :-

YUNGOLA SERVICES
LTD.

(ARCHITECTURAL DESIGN, STRUCTURAL DESIGN,
CONSULTANT,SUPERVISION)

OFFICE ADDRESS:

NO 2 OSHOGBO STREET,
OGUDU
LAGOS STATE
☎️ ; 08054178584, 07062539641

Office stamp

sheet
content:-

Plan

date :-

scale :-

1:100

sheet no :-

revision :-

Drawn by :-
Yungola


Checked by :-
Oluwaseun

OCTOBER, 2024

AS-BUILT BUILDING PLAN A

NOTE;

NOTE
ALL INTERNAL WALLS AND EXTERNAL WALLS ARE
225MM THICK
existing ground floor plan

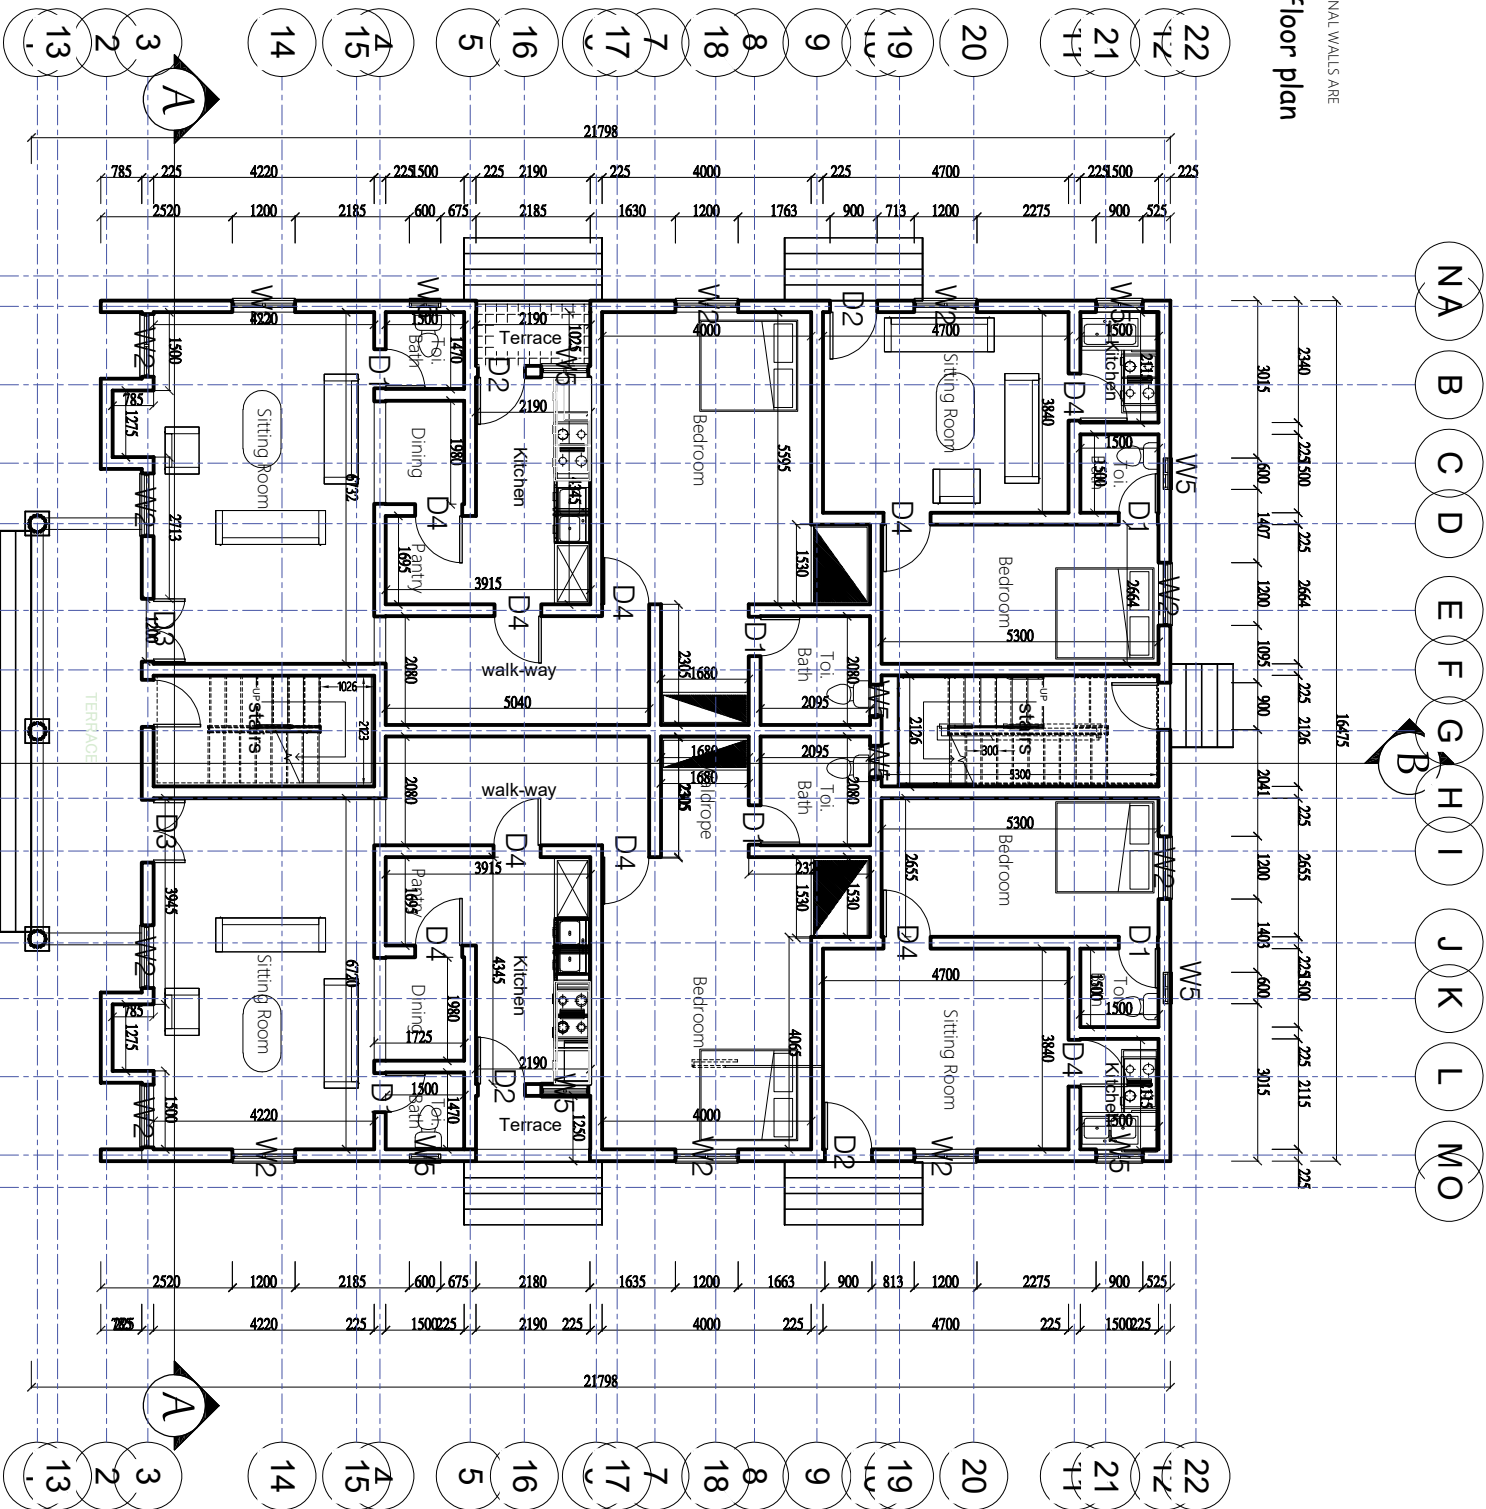

NOTE
ALL INTERNAL WALLS AND EXTERNAL WALLS ARE
225MM THICK
existing ground floor plan

EXISTING GROUND FLOOR PLAN

general note

- 1) The contractor is to check all the drawing before commencing work.
- 2) Any discrepancies observed on this drawing issued by any other party are to be immediately brought to consultant Architect Notice.
- 3) All dimension are in millimeter.
- 4) Dimension are to be confirmed on site.

Client :-

MR. ADEBAYO OLUWATOBI
ABIODUN

Location :-

ON DUKOSUSU FAMILY LAND
ALONG EGAN ROAD MOJODA ODO AYAN
EPE LOCAL GOVT AREA,
LAGOS STATE.

Project Title :-

As-Built Residential
Development

Architect :-

YUNGOLA SERVICES
LTD.

(ARCHITECTURAL DESIGN, STRUCTURAL DESIGN,
CONSULTANT,SUPERVISION)

OFFICE ADDRESS:

NO 2 OSHOGBO STREET,
OGUDU
LAGOS STATE
582 ; 08054178584, 07062539641

Office stamp

sheet
content:-

Plan

date :-

OCTOBER, 2024

sheet no :-

scale :-

1:100

revision :-


Drawn by :-

Yungola

Checked by :-

Oluwaseun

NOTE;

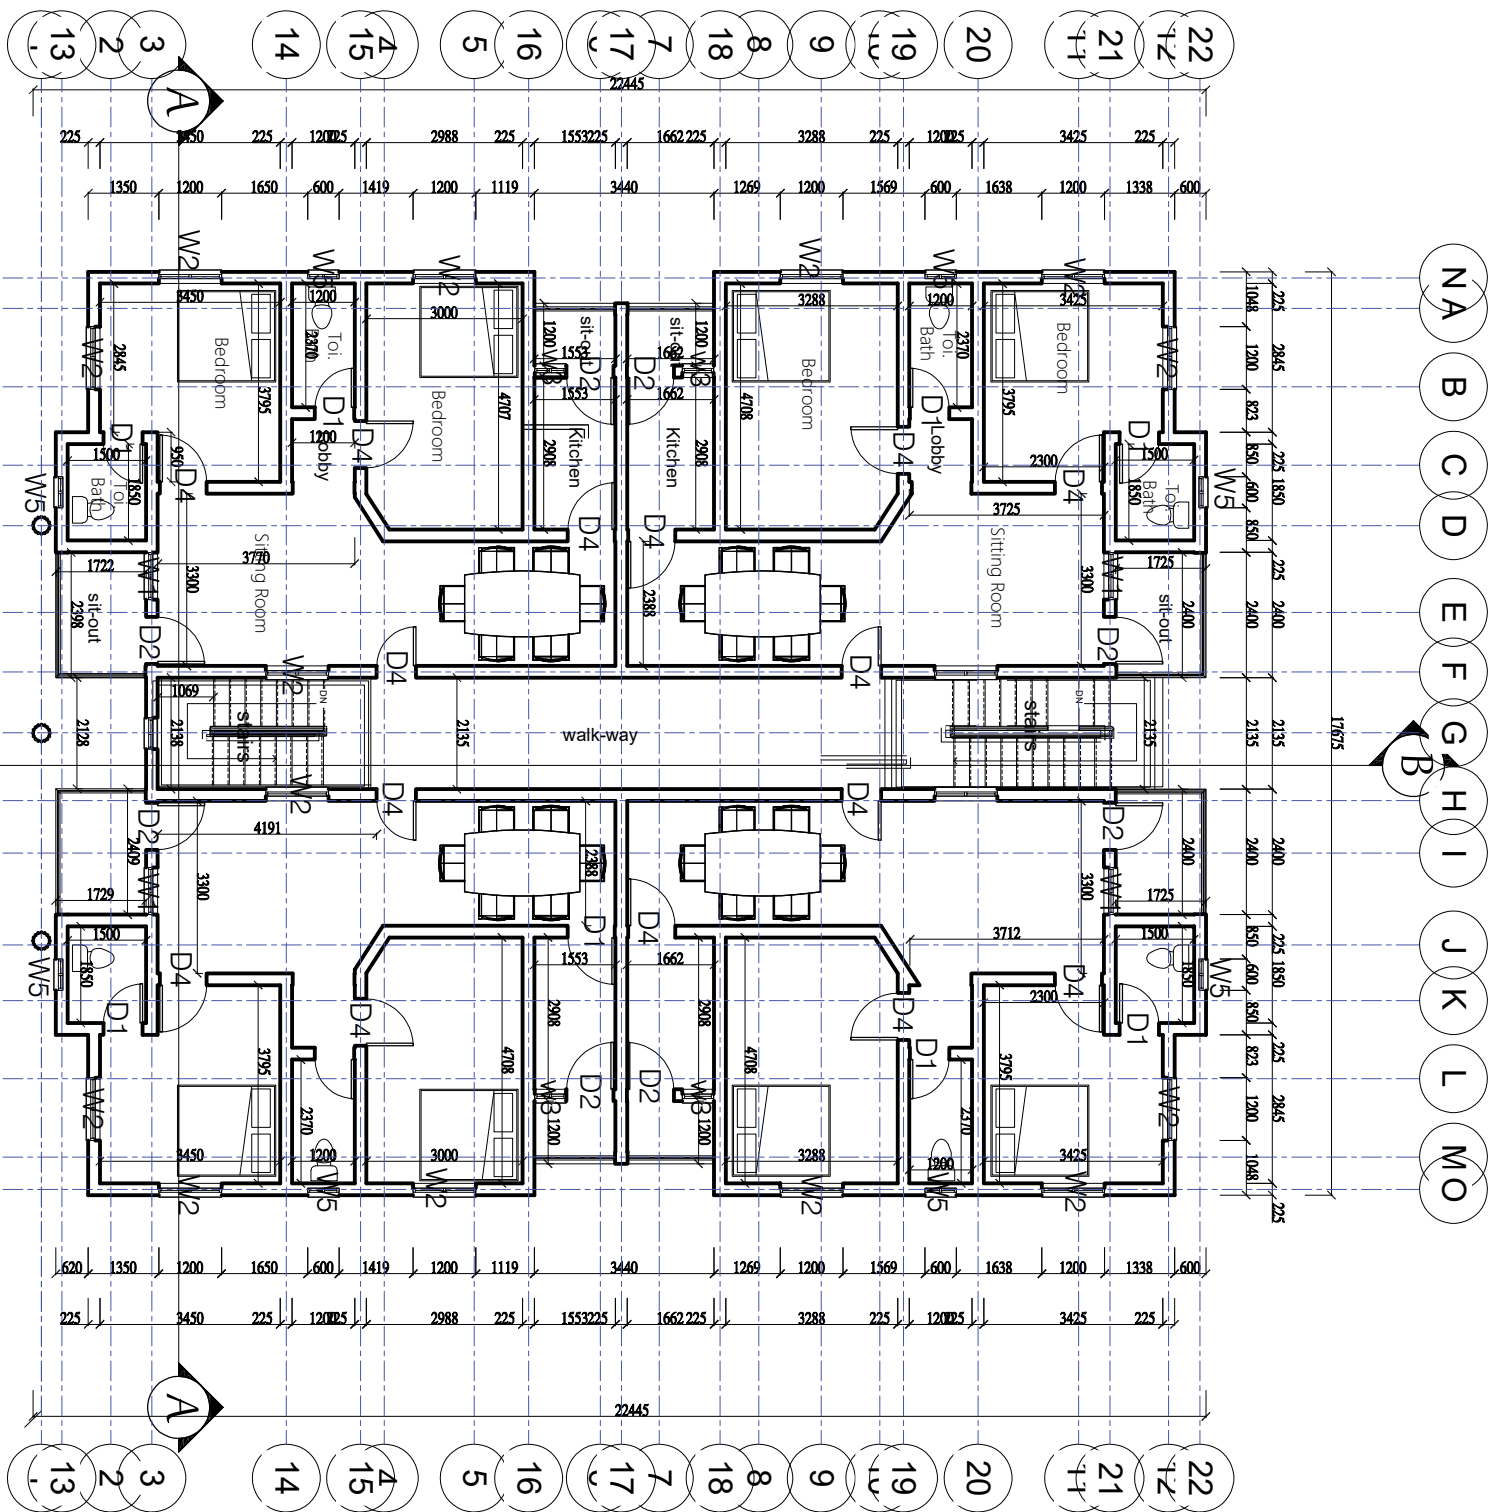

UPPER FLOOR PLAN

general note

- 1) The contractor is to check all the drawing before commencing work.
- 2) Any discrepancies observed on this drawing issued by any other party are to be immediately brought to consultant Architect Notice.
- 3) All dimension are in millimeter.
- 4) Dimension are to be confirmed on site.

Client :-

MR. ADEBAYO OLUWATOBI
ABIODUN

Location :-

ON DUKOSUSU FAMILY LAND
ALONG EGAN ROAD MOJODA ODO AYAN
EPE LOCAL GOVT AREA,
LAGOS STATE.

Project Title :-

As-Built Residential
Development

Architect :-

YUNGOLA SERVICES
LTD.
(ARCHITECTURAL DESIGN, STRUCTURAL DESIGN,
CONSULTANT,SUPERVISION)

OFFICE ADDRESS:
NO 2 OSHOGBO STREET,
OGUDU
LAGOS STATE
☎️ ; 08054178584, 07062539641

Office stamp

sheet
content:-

Plan

date :-

OCTOBER, 2024

sheet no :-

scale :-

1:100

revision :-


Drawn by :-

Yungola

Checked by :-

Oluwaseun

NOTE;

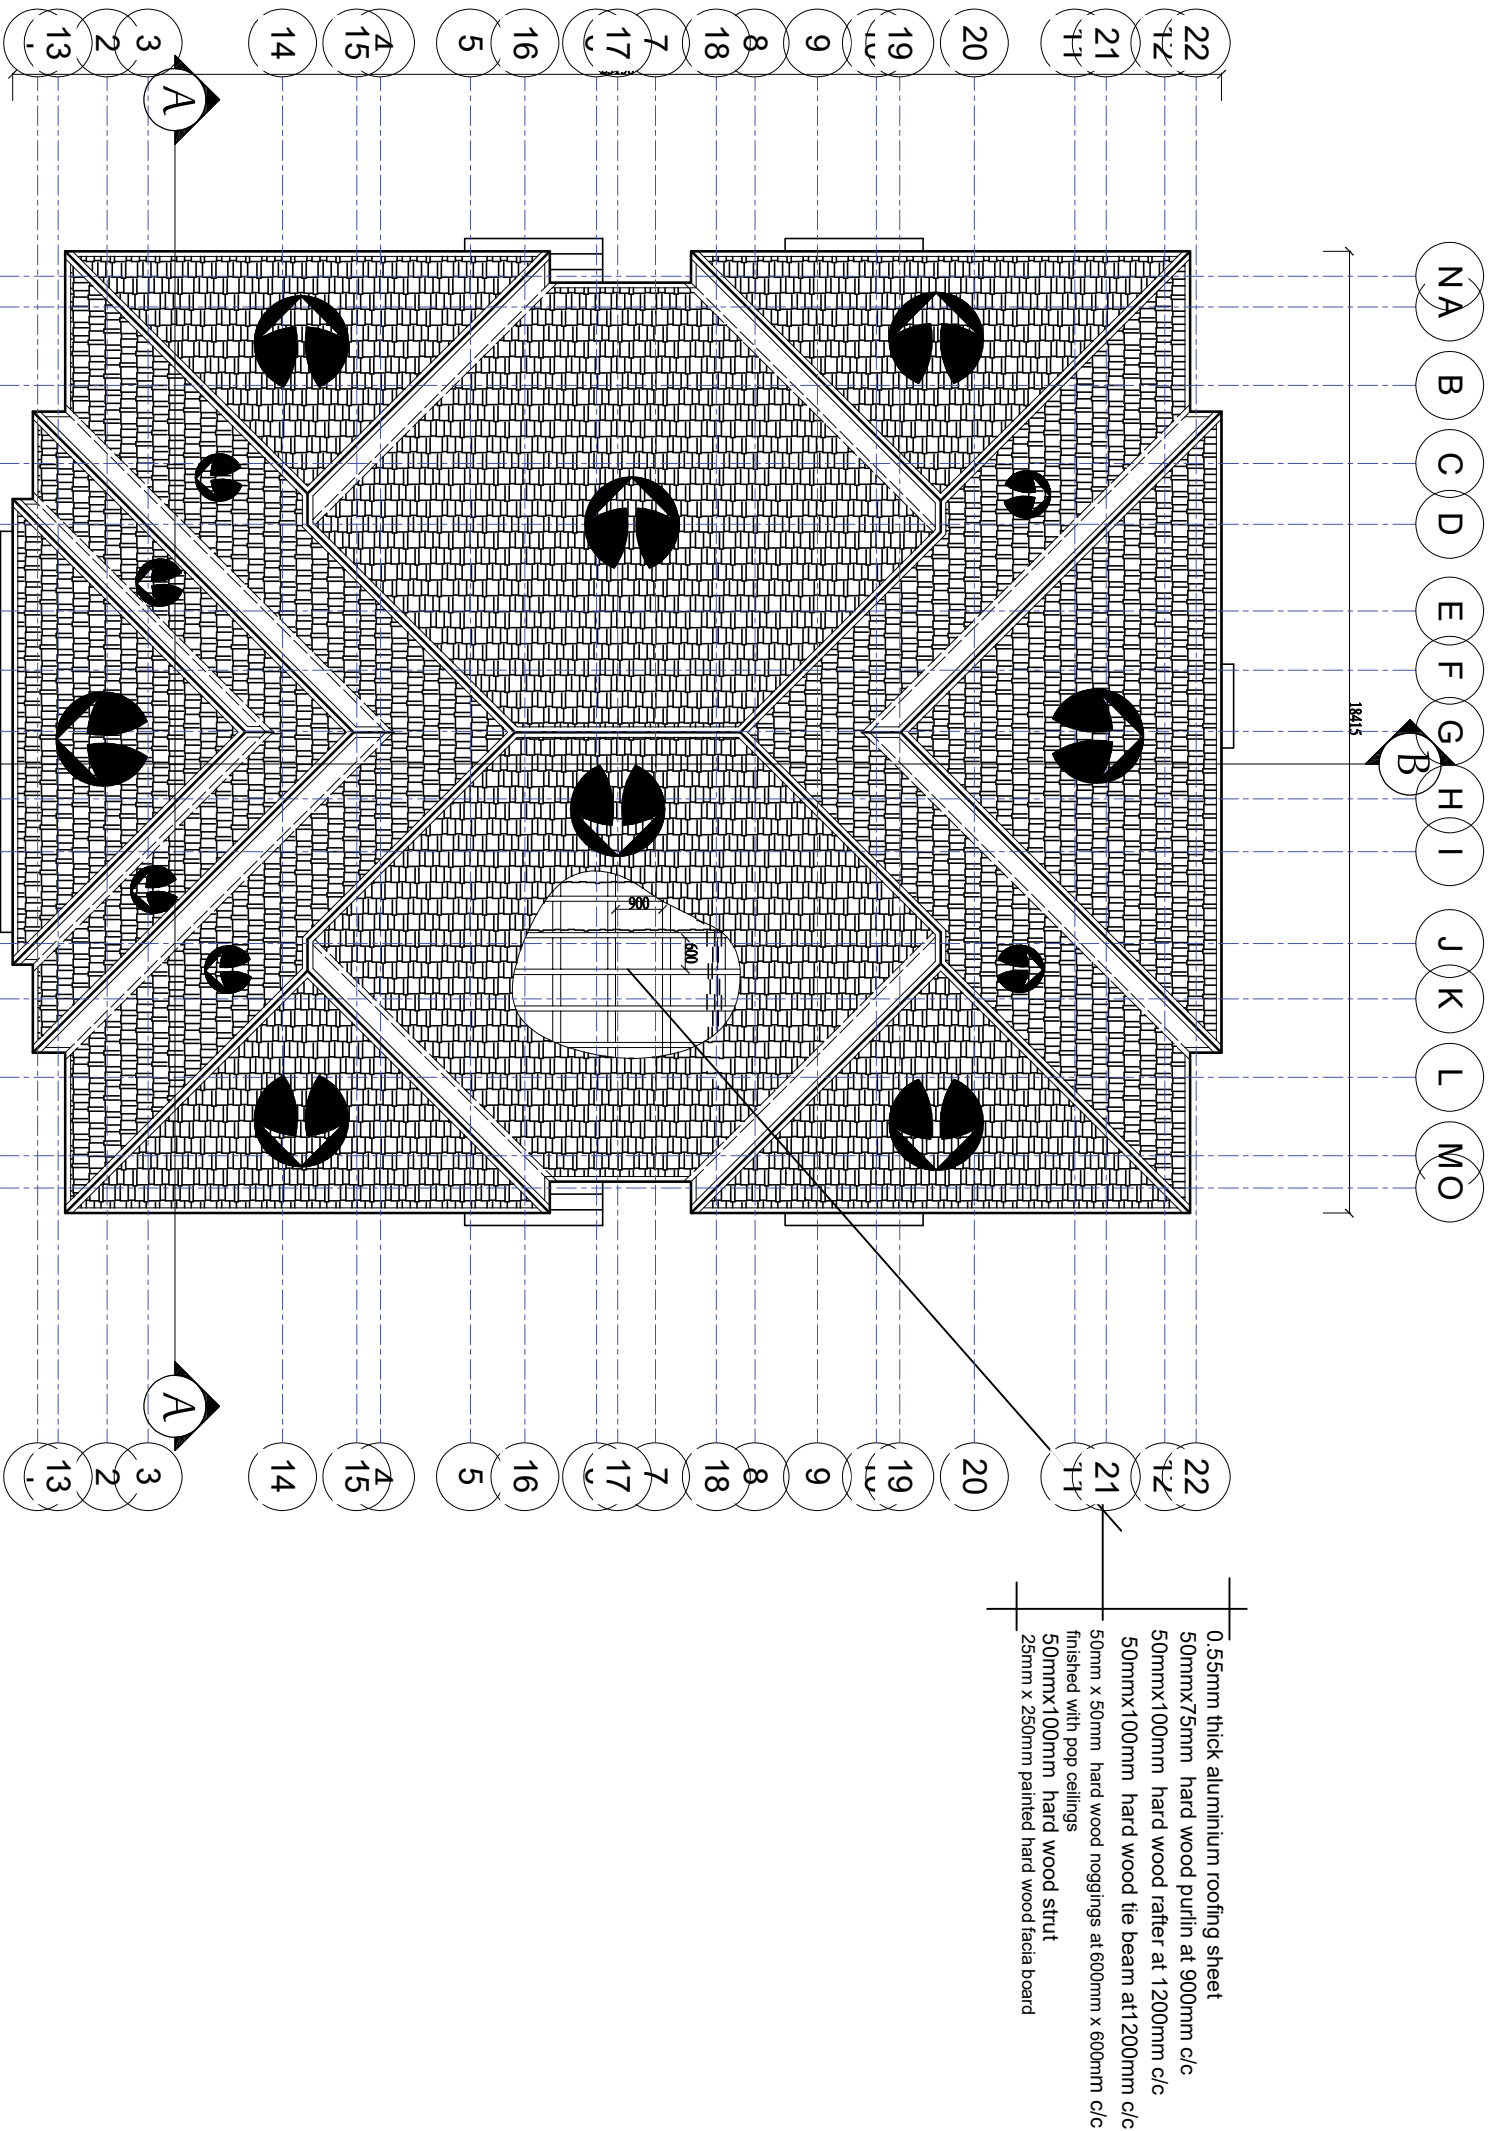

ROOF PLAN

general note

- 1) The contractor is to check all the drawing before commencing work.
- 2) Any discrepancies observed on this drawing issued by any other party are to be immediately brought to consultant Architect Notice.
- 3) All dimension are in millimeter.
- 4) Dimension are to be confirmed on site.

Client :-

MR. ADEBAYO OLUWATOBI
ABIODUN

Location :-

ON DUKOSUSU FAMILY LAND
ALONG EGAN ROAD MOJODA ODO AYAN
EPE LOCAL GOVT AREA,
LAGOS STATE.

Project Title :-

As-Built Residential
Development

Approval
Drawing

Architect :-

YUNGOLA SERVICES
LTD.
(ARCHITECTURAL DESIGN, STRUCTURAL DESIGN,
CONSULTANT,SUPERVISION)

OFFICE ADDRESS:

NO 2 OSHOGBO STREET,
OGUDU
LAGOS STATE
☎ ; 08054178584, 07062539641

Office stamp

sheet
content:-

Plan

date :-

scale :-

1:100

sheet no :-

revision :-

Drawn by :-

Checked by :-


Yungola

Oluwaseun

OCTOBER, 2024

NOTE;

50 X 100mm H/W WELL-SEASONED RAFTER@1500mm c/c
75 X 100mm H/W WELL-SEASONED WALL-PLATE ON LOAD-BEARING WALL
50 X 100mm H/W WELL-SEASONED STRUCTS
75 X 150mm H/W WELL-SEASONED TIE BEAM@1500mm c/c
75 X 150mm H/W WELL-SEASONED KINGPOST@1500mm c/c
50 X 50mm S/W NOGGINS
600mm EAVE PROJECTION

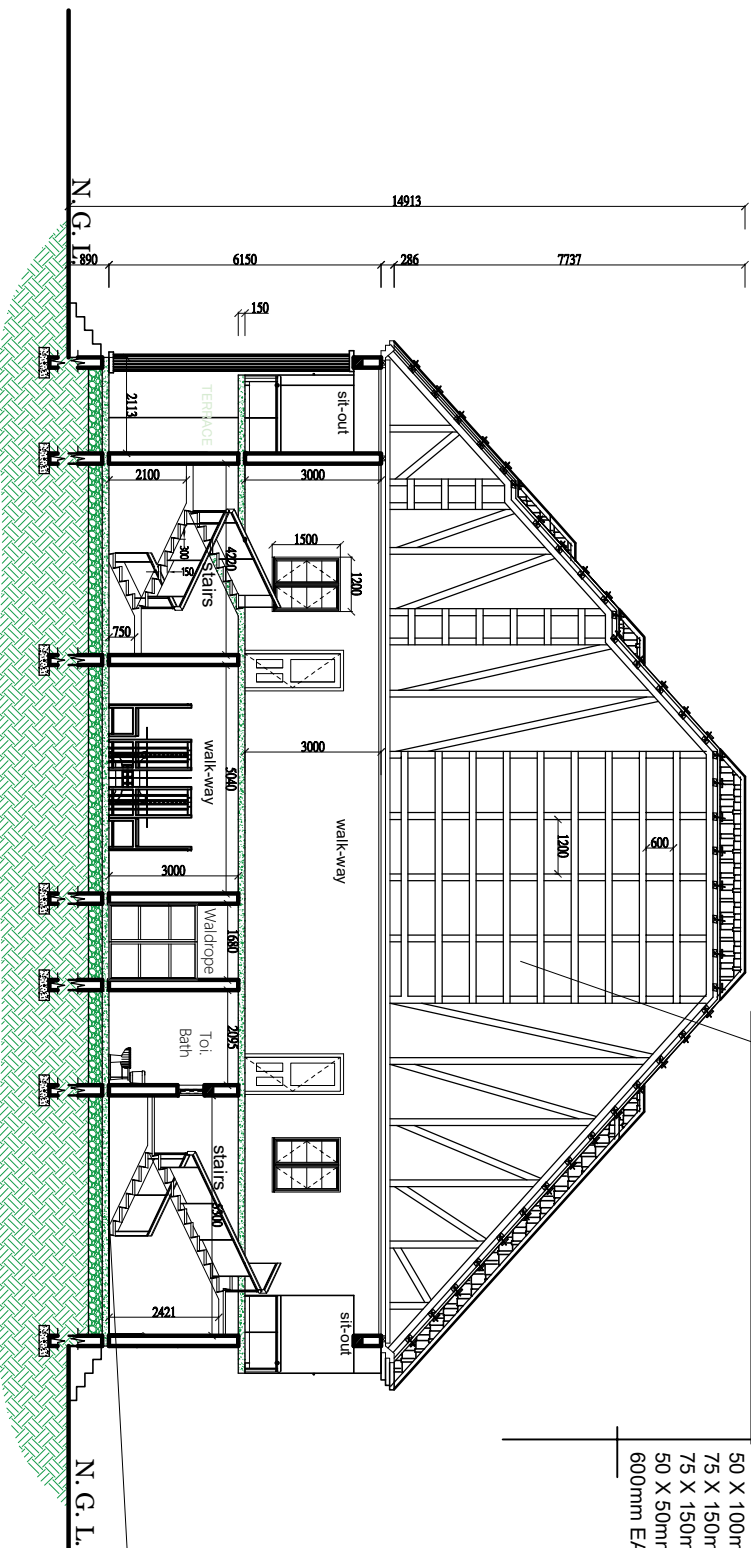


150mmT concrete slab over polythene DPM of 50mm blinding
300mm well-compacted Hardcore bed
Earth filling to be well compacted in layers

SECTION B - B

0.55mm GUAGE LONGSPAN ALUMINIUM ROOFING SHEET
50 X 75mm HW WELL-SEASONED PURLIN@900mm c/c
50 X 100mm HW WELL-SEASONED RAFTER@1500mm c/c
75 X 100mm H/W WELL-SEASONED WALL-PLATE ON LOAD-BEARING WALL
50 X 100mm HW WELL-SEASONED STRUTS
75 X 150mm HW WELL-SEASONED THE BEAM@1500mm c/c
75 X 150mm H/W WELL-SEASONED KINGPOST@1500mm c/c
50 X 50mm S/W NOGGINS
600mm EAVE PROJECTION

150mmT concrete slab over polythene DPM of 50mm blinding
300mm well-compacted Hardcore bed
Earth filling to be well compacted in layers

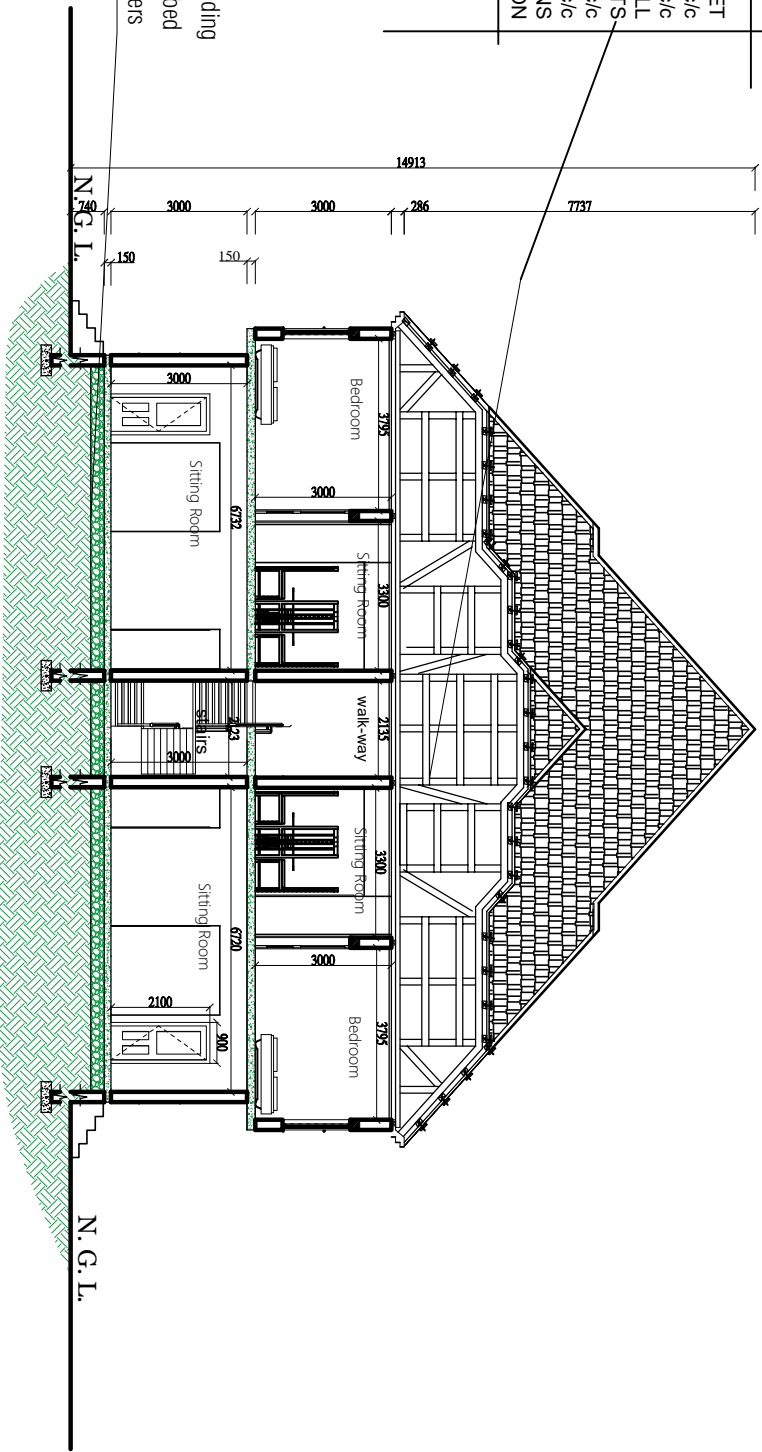

SECTION A - A

general note

- 1) The contractor is to check all the drawing before commencing work.
- 2) Any discrepancies observed on this drawing issued by any other party are to be immediately brought to consultant Architect Notice.
- 3) All dimension are in millimeter.
- 4) Dimension are to be confirmed on site.

Client :-

**MR. ADEBAYO
OLUWATOBI ABIODUN**

Location :-

ON DUDOSU FAMILY LAND
ALONG EGAN ROAD MOJODA ODO AYAN
EPE LOCAL GOVT AREA,
LAGOS STATE.

Project Title :-

As-Built Residential Development

Approval
Drawing

Architect :-

YUNGOLA SERVICES
LTD.

(ARCHITECTURAL DESIGN, STRUCTURAL DESIGN,
CONSULTANT,SUPERVISION)

OFFICE ADDRESS:

NO 2 OSHOGBO STREET,
OGUDU,
LAGOS STATE
08054178584, 0706253964

Office stamp

sheet
content:—

Plan

date : —

OCTOBER, 2024


sheet no :-

scale : -


revision : -

Drawn by :-
Yungola
Checked by :-

NOTE;

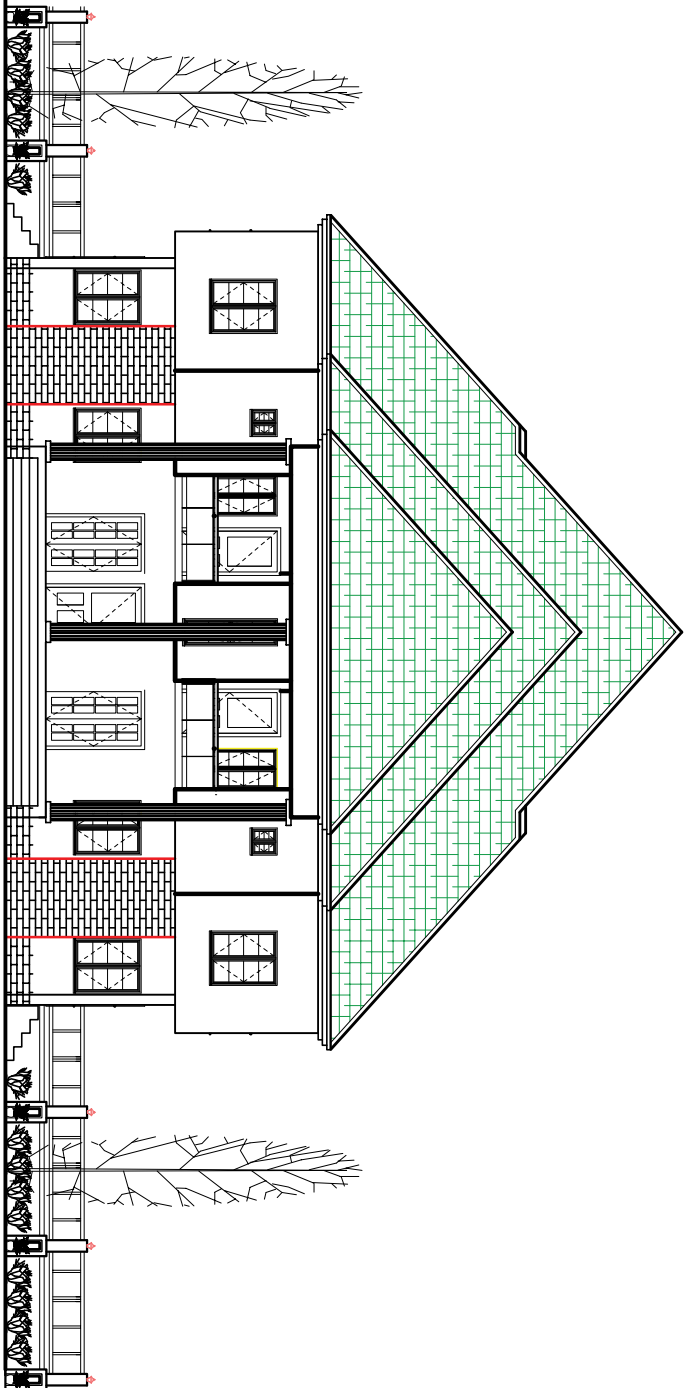

FRONT VIEW

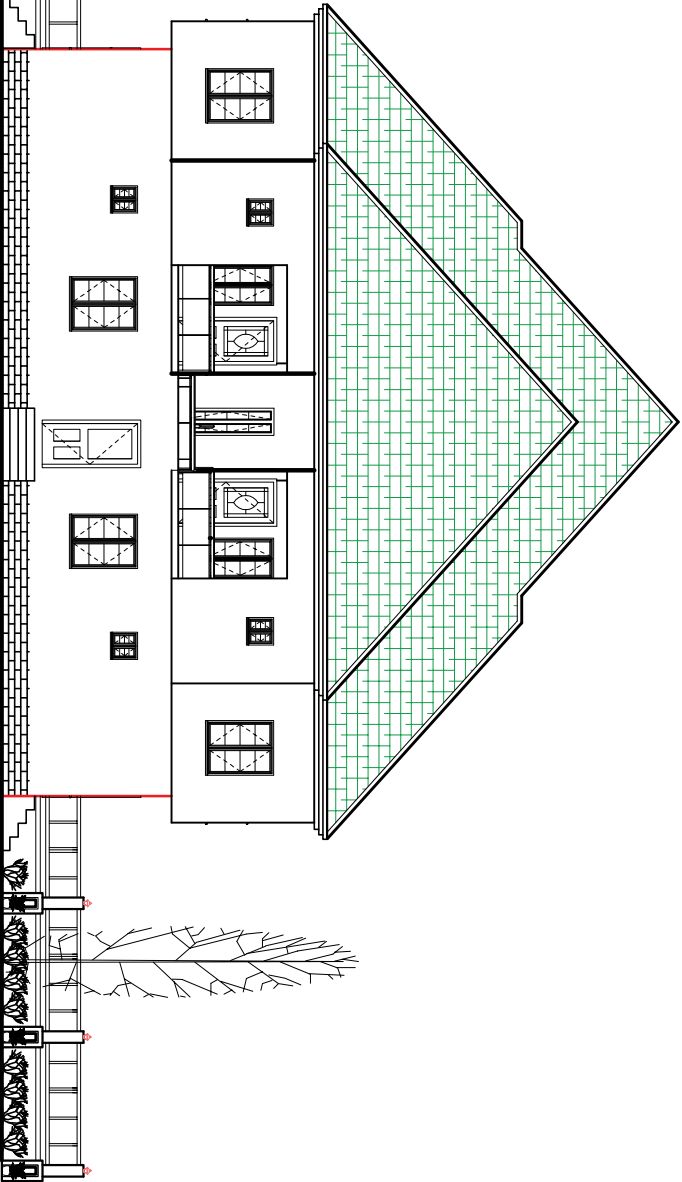

BACK VIEW

general note

- 1) The contractor is to check all the drawing before commencing work.
- 2) Any discrepancies observed on this drawing issued by any other party are to be immediately brought to consultant Architect Notice.
- 3) All dimension are in millimeter.
- 4) Dimension are to be confirmed on site.

Client :-

MR. ADEBAYO
OLUWATOBI ABIODUN

Location :-

ON DUROSUSU FAMILY LAND
ALONG EGAN ROAD MOJODA ODO AYAN
EPE LOCAL GOVT AREA,
LAGOS STATE.

Project Title :-

As-Built Residential
Development

Approval
Drawing

Architect :-

YUNGOLA SERVICES
LTD.

(ARCHITECTURAL DESIGN, STRUCTURAL DESIGN,
CONSULTANT,SUPERVISION)

OFFICE ADDRESS:

NO 2 OSHOGBO STREET,
OGUDU
LAGOS STATE
☎️ ; 08054178584, 07062539641

Office stamp

sheet
content:-

Plan

date :-

sheet no :-

scale :-

1:100

revision :-

Drawn by :-


Yungola

Checked by :-


Oluwaseun

OCTOBER, 2024

NOTE;

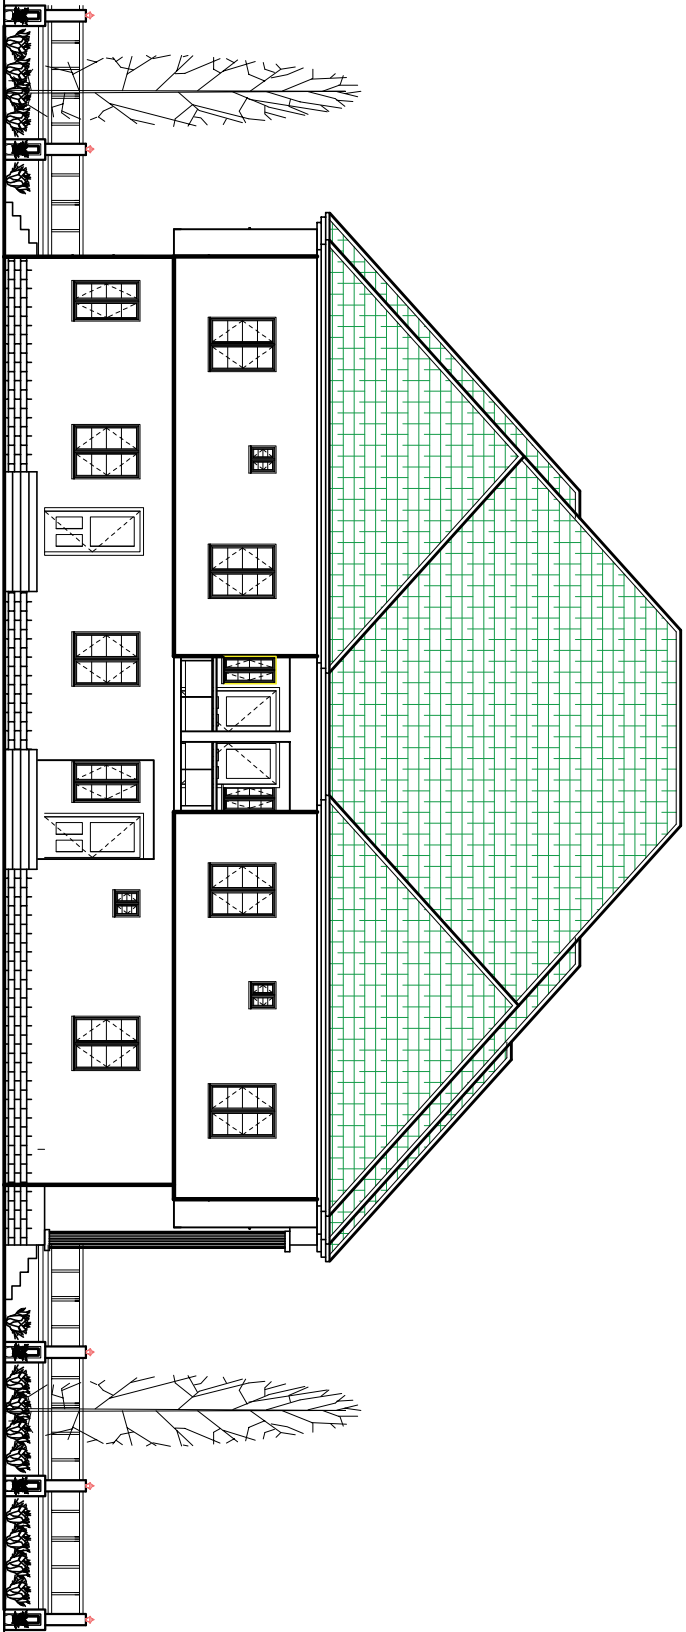

RIGHT VIEW

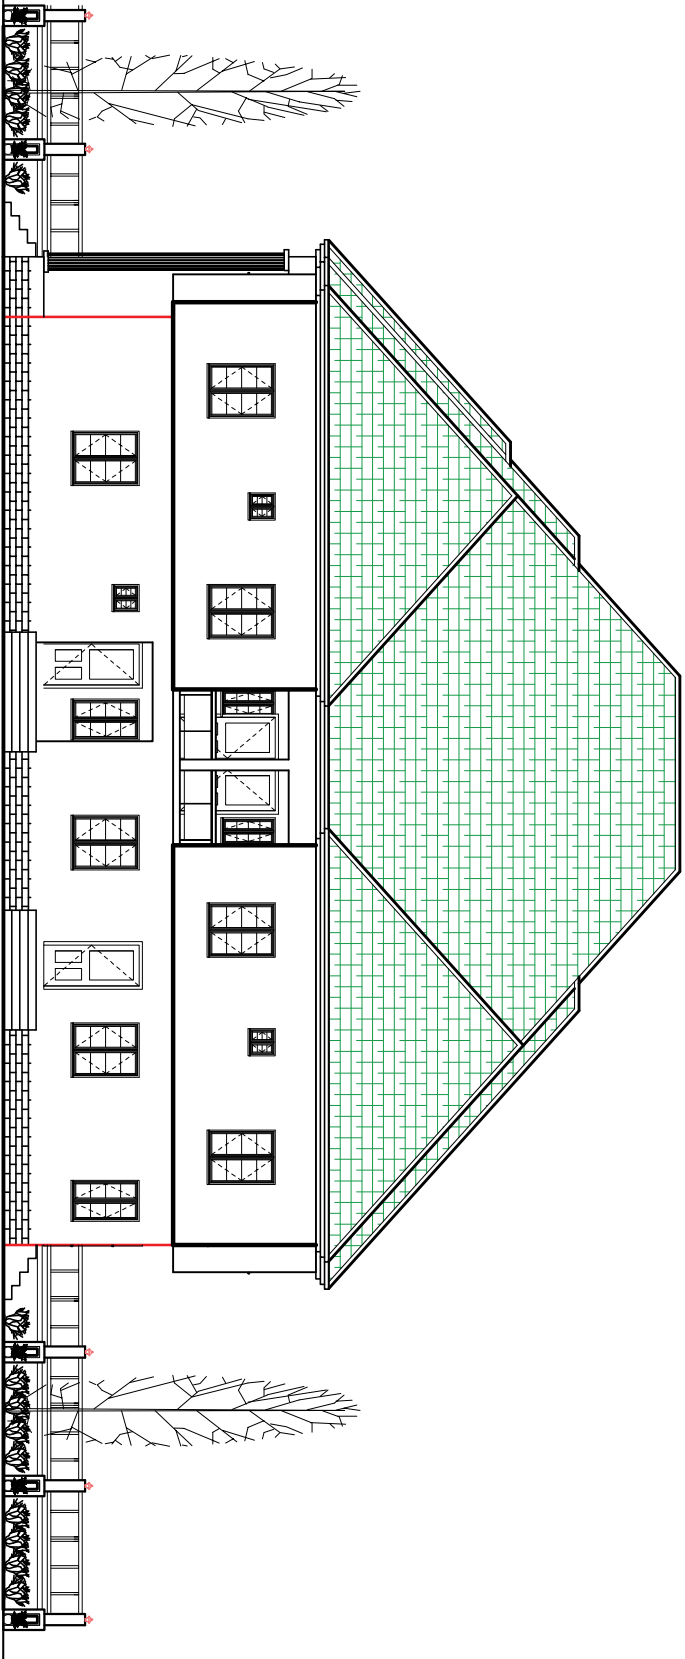

LEFT VIEW

general note

- 1) The contractor is to check all the drawing before commencing work.
- 2) Any discrepancies observed on this drawing issued by any other party are to be immediately brought to consultant Architect Notice.
- 3) All dimension are in millimeter.
- 4) Dimension are to be confirmed on site.

Client :-

MR. ADEBAYO
OLUWATOBI ABIODUN

Location :-

ON DUKOSUSU FAMILY LAND
ALONG EGAN ROAD MOJODA ODO AYAN
EPE LOCAL GOVT AREA,
LAGOS STATE.

Project Title :-

As-Built Residential
Development

Approval
Drawing

Architect :-

YUNGOLA SERVICES
LTD.

(ARCHITECTURAL DESIGN, STRUCTURAL DESIGN,
CONSULTANT,SUPERVISION)

OFFICE ADDRESS:

NO 2 OSHOGBO STREET,
OGUDU
LAGOS STATE
☎️ ; 08054178584, 07062539641

Office stamp

sheet
content:-

Plan

date :-

scale :-

1:100

sheet no :-

revision :-

Drawn by :-





Yungola



Checked by :-





Oluwaseun

OCTOBER, 2024

NOTE;

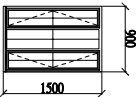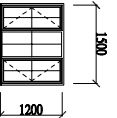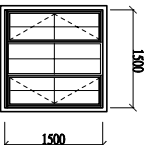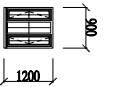WINDOWS SCHEDULE						
PROFILE						
LABEL ON PLAN	W1	W2	W3	W4	W5	W6
NO'S REQD	4	26	4	2	14	4
DESCRIPTION	Aluminum casement windows with burglary bars, fly and mosquito screen					
DIMENSION (MM)	750 x 1500	1200 X 1200	750 x 1200	1500 x 1500	600 X 600	900 x 1200
						600 X 5200

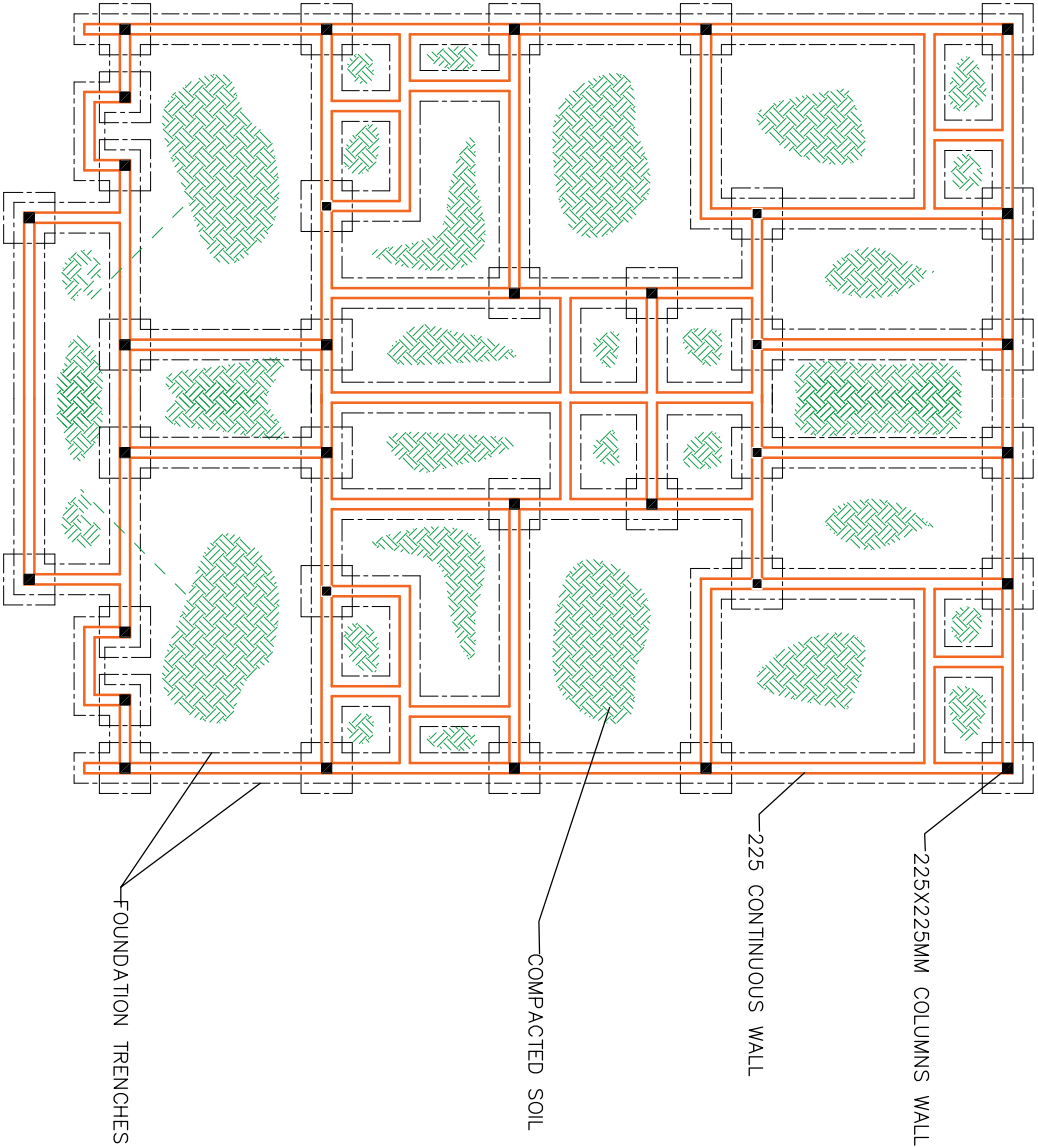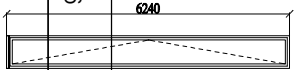

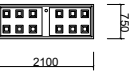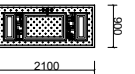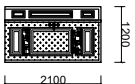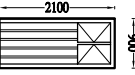DOORS SCHEDULE					
PROFILE					
LABEL ON PLAN	D1	D2	D3	D4	
NO'S REQD	14	12	2	26	
DESCRIPTION	Single action, single leaf steel panel door with steel frame see manufacturers fixing catalogue for details.	Single action, single leaf steel panel door with steel frame see manufacturers fixing catalogue for details.	Double action, Double leaf steel panel door with steel frame see manufacturers fixing catalogue for details.	Single action, single leaf steel panel door with steel frame see manufacturers fixing catalogue for details.	
DIMENSION (MM)	750 X 2100	900 X 2100	1200 X 2100	900 X 2100	

SCHEDULE

EXISTING FOUNDATION FOOTING/PLAN

general note

1) The contractor is to check all the drawing before commencing work.
2) Any discrepancies observed on this drawing issued by any other party are to be immediately brought to consultant Architect Notice.
3) All dimension are in millimeter.
4) Dimension are to be confirmed on site.

Client :-
MR. ADEBAYO OLUWATOBI ABIODUN

Location :-
ON DUKOSUSU FAMILY LAND
ALONG EGAN ROAD MOJODA ODO AYAN
EPE LOCAL GOVT AREA,
LAGOS STATE.

Project Title :-
As-Built Residential Development

Architect :-
YUNGOLA SERVICES LTD.
(ARCHITECTURAL DESIGN, STRUCTURAL DESIGN, CONSULTANT,SUPERVISION)

OFFICE ADDRESS:
NO 2 OSHOGBO STREET,
OGUDU
LAGOS STATE
☎️ ; 08054178584, 07062539641

Office stamp

sheet content:-

Plan

date : -

scale : -

1:100

revision : -

sheet no :-

Drawn by :-
Yungola

Checked by :-
Oluwaseun


10

OCTOBER, 2024


AS-BUILT BUILDING PLAN B

NOTE;

0.55mm thick aluminium roofing sheet
50mmx75mm hard wood purlin at 900mm c/c
50mmx100mm hard wood rafter at 1200mm c/c
50mmx100mm hard wood tie beam at 1200mm c/c
50mm x 50mm hard wood noggings at 600mm x 600mm c/c
finished with pop ceilings
50mmx100mm hard wood strut
25mm x 250mm painted hard wood fascia board

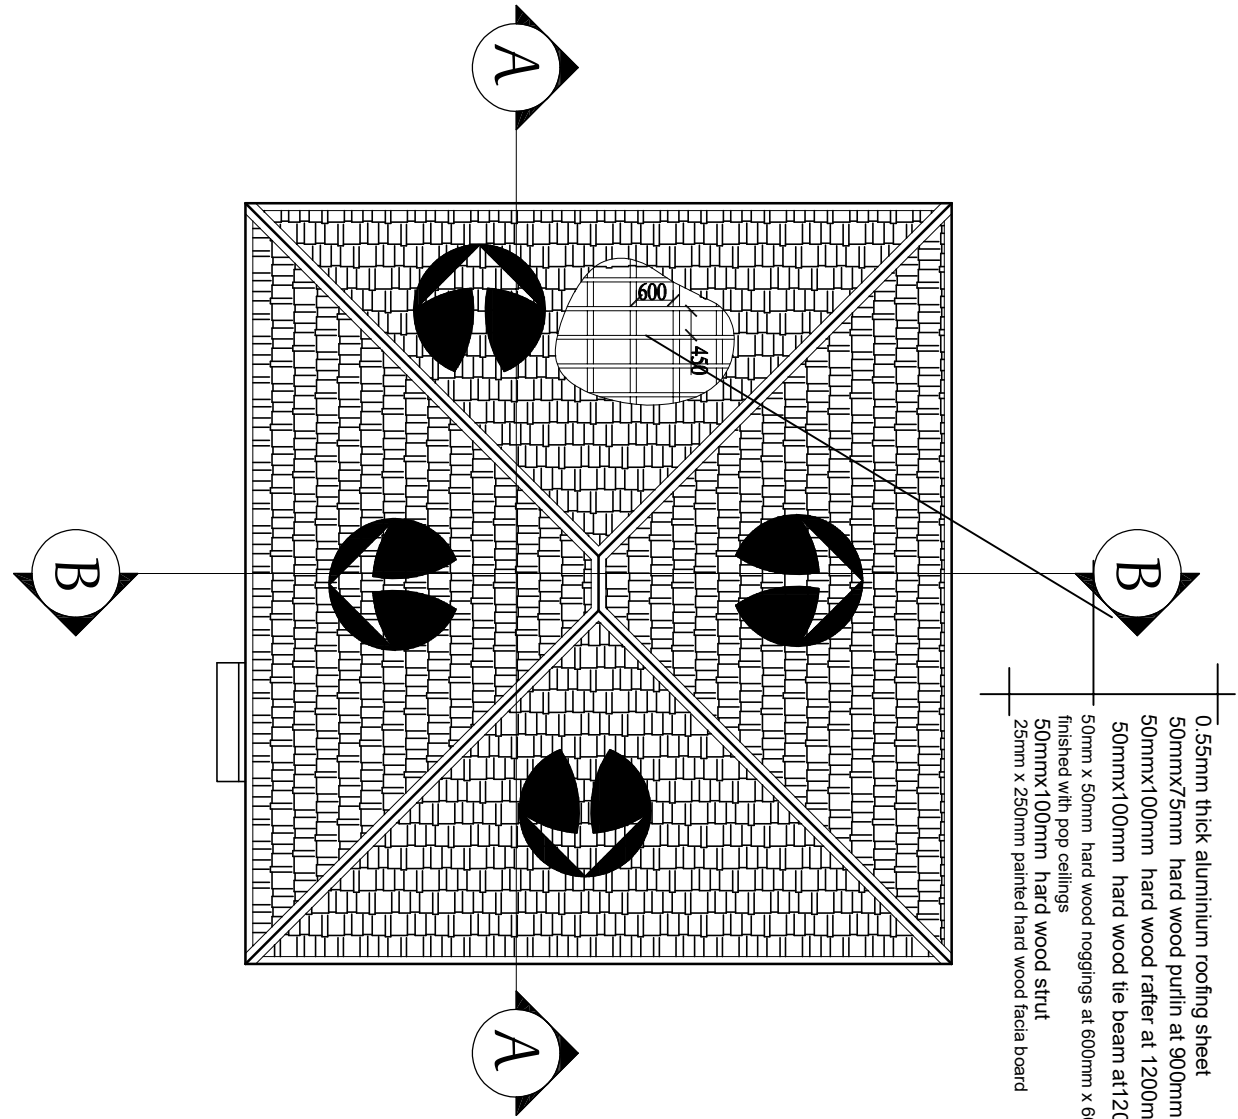

ROOF PLAN

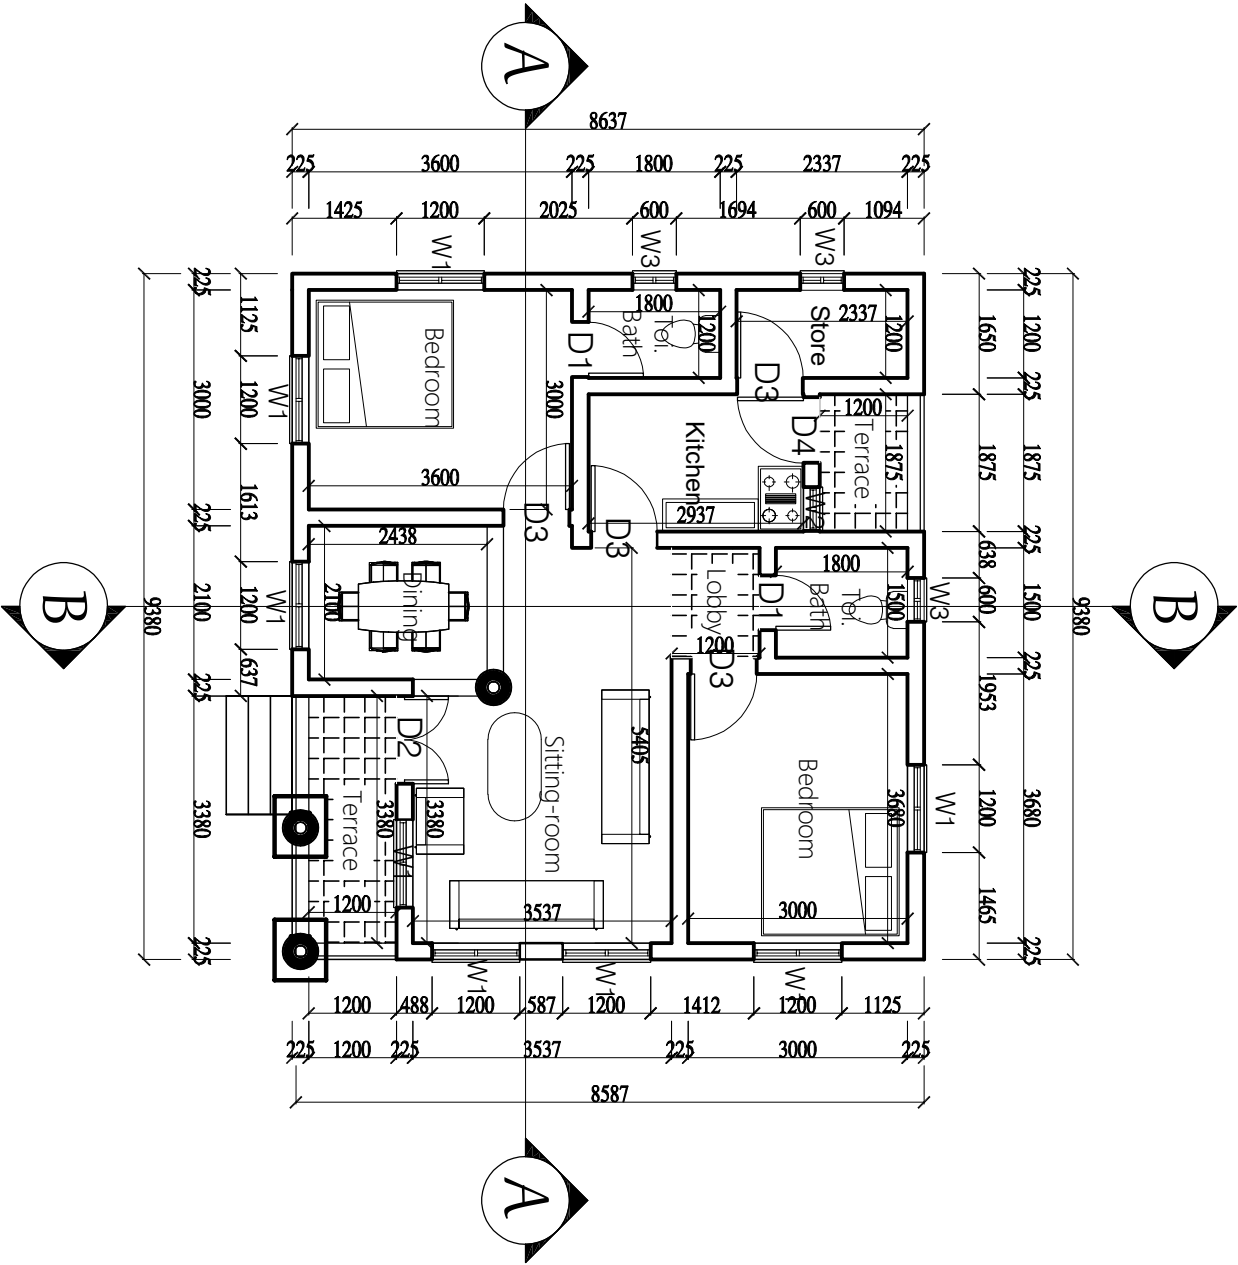

FLOOR PLAN

general note

- 1) The contractor is to check all the drawing before commencing work.
- 2) Any discrepancies observed on this drawing issued by any other party are to be immediately brought to consultant Architect Notice.
- 3) All dimension are in millimeter.
- 4) Dimension are to be confirmed on site.

Client :-

MR. ADEBAYO
OLUWATOBI ABIODUN

Location :-

ON DUROSUSU FAMILY LAND
ALONG EGAN ROAD MOJODA ODO
AYAN
EPE LOCAL GOVT AREA,
LAGOS STATE.

Project Title :-

As-Built Residential
Development

Architect :-

YUNGOLA SERVICES
LTD.

(ARCHITECTURAL DESIGN, STRUCTURAL DESIGN,
CONSULTANT,SUPERVISION)

OFFICE ADDRESS:

NO 2 OSHOGBO STREET,
OGUDU
LAGOS STATE
Tel ; 08054178584, 07062539641

Office stamp

sheet
content:-

Plan

date :-

OCTOBER, 2024

sheet no :-

scale :-

1:100

revision :-

Drawn by :-


Yungola

Checked by :-

Oluwaseun

NOTE;


0.55mm GUAGE LONGSPAN ALUMINIUM ROOFING SHEET
50 X 75mm H/W WELL-SEASONED PURLIN@900mm c/c
50 X 100mm H/W WELL-SEASONED RAFTER@1500mm c/c
75 X 100mm H/W WELL-SEASONED WALL-PLATE ON LOAD-BEARING WALL
50 X 100mm H/W WELL-SEASONED STRUCTS
75 X 150mm H/W WELL-SEASONED TIE BEAM@1500mm c/c
75 X 150mm H/W WELL-SEASONED KINGPOST@1500mm c/c
50 X 50mm S/W NOGGINS
600mm EAVE PROJECTION

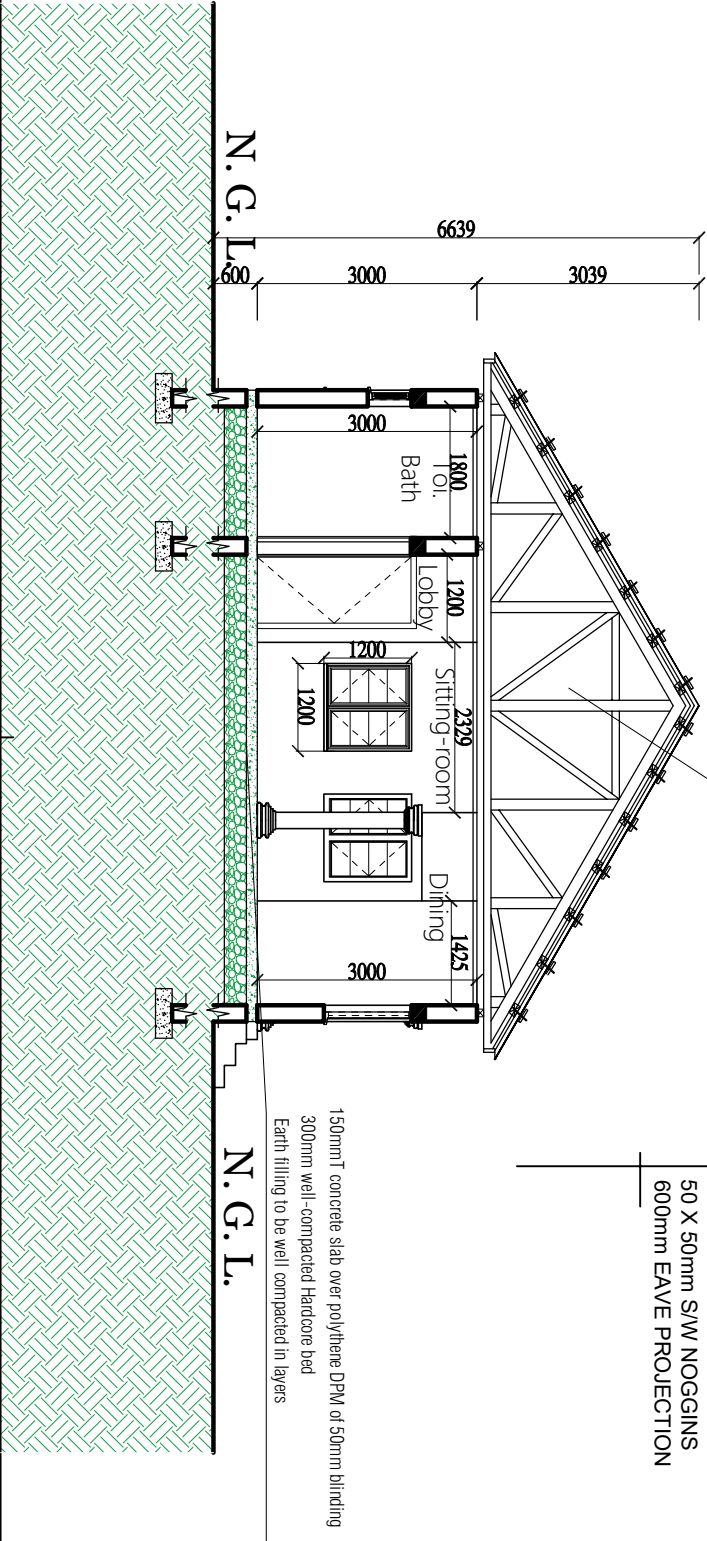

SECTION B - B

0.55mm GUAGE LONGSPAN ALUMINIUM ROOFING SHEET
50 X 75mm H/W WELL-SEASONED PURLIN@900mm c/c
50 X 100mm H/W WELL-SEASONED RAFTER@1500mm c/c
75 X 100mm H/W WELL-SEASONED WALL-PLATE ON LOAD-BEARING WALL
50 X 100mm H/W WELL-SEASONED STRUCTS
75 X 150mm H/W WELL-SEASONED TIE BEAM@1500mm c/c
75 X 150mm H/W WELL-SEASONED KINGPOST@1500mm c/c
50 X 50mm S/W NOGGINS
600mm EAVE PROJECTION

150mmT concrete slab over polythene DPM of 50mm blinding
300mm well-compacted Hardcore bed
Earth filling to be well compacted in layers

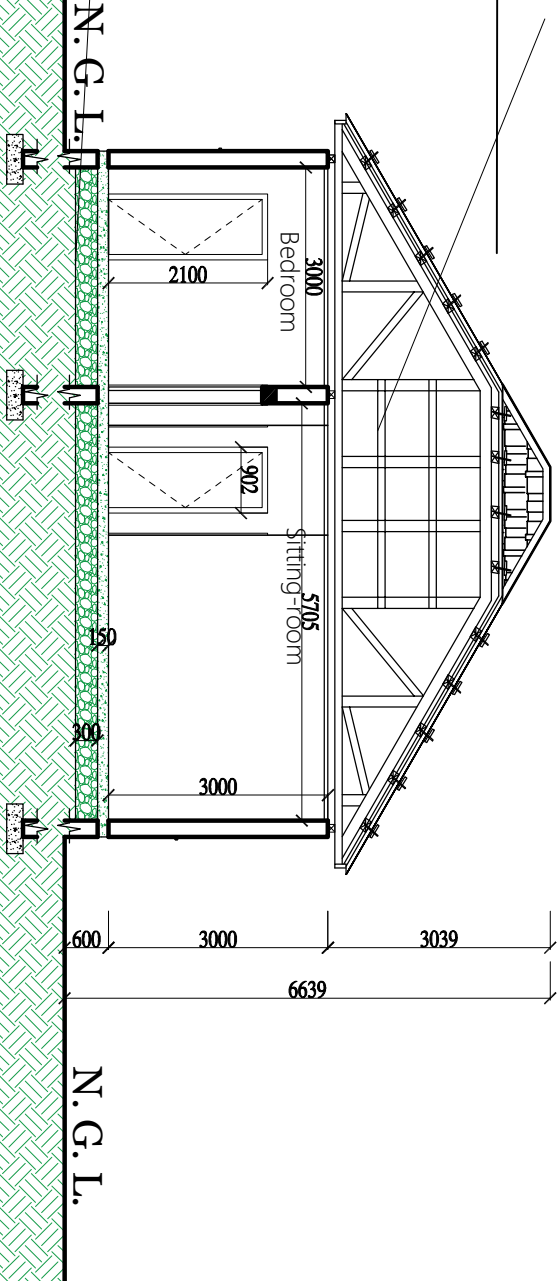

SECTION A - A

general note

- 1) The contractor is to check all the drawing before commencing work.
- 2) Any discrepancies observed on this drawing issued by any other party are to be immediately brought to consultant Architect Notice.
- 3) All dimension are in millimeter.
- 4) Dimension are to be confirmed on site.

Client :-

MR. ADEBAYO
OLUWATOBI ABIODUN

Location :-

ON DUROSUSU FAMILY LAND
ALONG EGAN ROAD MOJODA ODO
AYAN
EPE LOCAL GOVT AREA,
LAGOS STATE.

Project Title :-

As-Built Residential
Development

Architect :-

YUNGOLA SERVICES
LTD.

(ARCHITECTURAL DESIGN, STRUCTURAL DESIGN,
CONSULTANT,SUPERVISION)

OFFICE ADDRESS:

NO 2 OSHOGBO STREET,
OGUDU
LAGOS STATE
☎️ ; 08054178584, 07062539641

Office stamp

sheet
content:-

Plan


date :-

sheet no :-

scale :-

1:100

revision :-

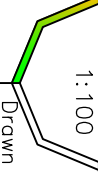


Drawn by :-
Yungola


Checked by :-
Oluwaseun

OCTOBER, 2024

NOTE;

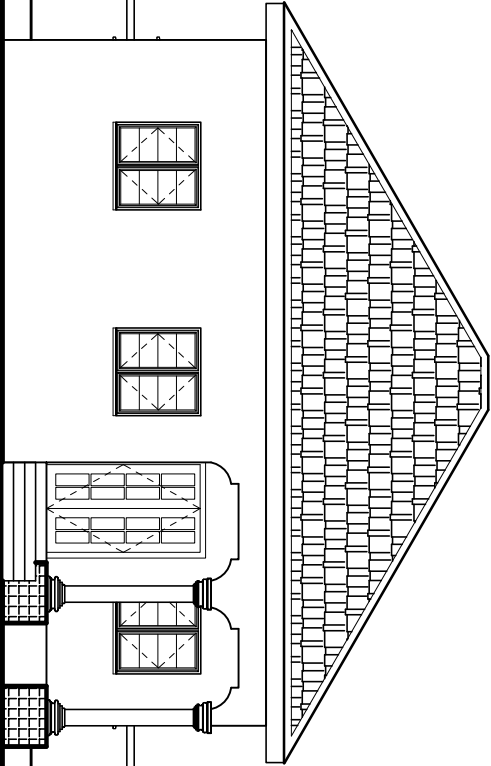

FRONT VIEW

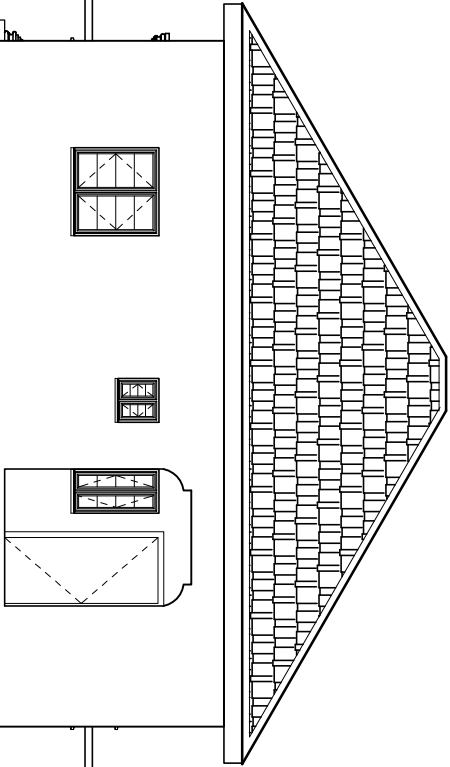

BACK VIEW

general note

- 1) The contractor is to check all the drawing before commencing work.
- 2) Any discrepancies observed on this drawing issued by any other party are to be immediately brought to consultant Architect Notice.
- 3) All dimension are in millimeter.
- 4) Dimension are to be confirmed on site.

Client :-

MR. ADEBAYO
OLUWATOBI ABIODUN

Location :-

ON DUROSUSU FAMILY LAND
ALONG EGAN ROAD MOJODA ODO
AYAN
EPE LOCAL GOVT AREA,
LAGOS STATE.

Project Title :-

As-Built Residential
Development

Approval
Drawing

Architect :-

YUNGOLA SERVICES
LTD.

(ARCHITECTURAL DESIGN, STRUCTURAL DESIGN,
CONSULTANT,SUPERVISION)

OFFICE ADDRESS:

NO 2 OSHOGBO STREET,
OGUDU
LAGOS STATE
TEL ; 08054178584, 07062539641

Office stamp

sheet
content:-

Plan

date :-

sheet no :-

scale :-

1:100

revision :-

Drawn by :-


Yungola

Checked by :-


Oluwaseun

OCTOBER, 2024

NOTE;

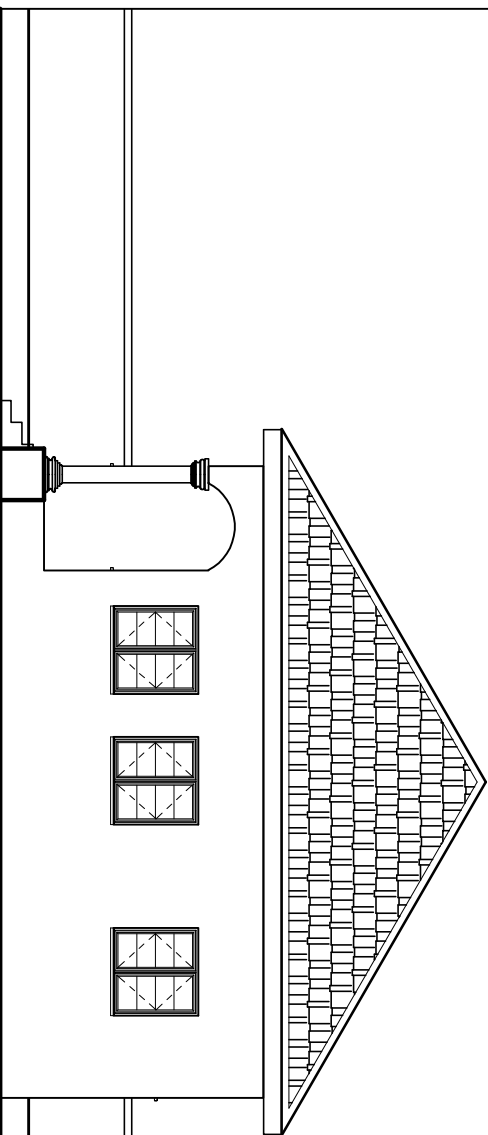

RIGHT VIEW

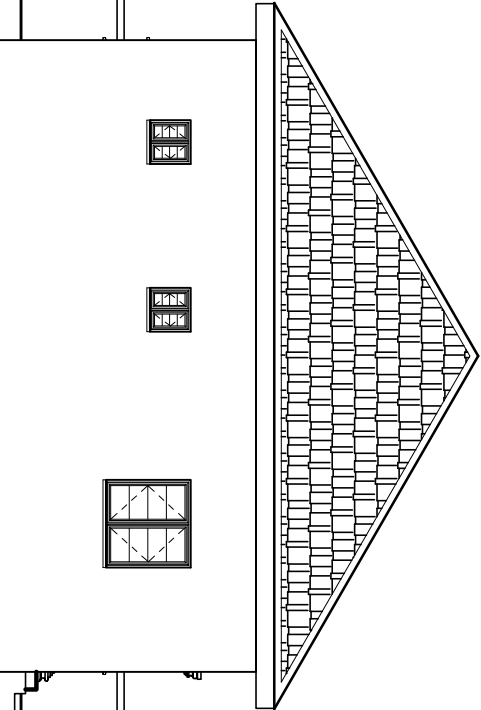

LEFT VIEW

general note

- 1) The contractor is to check all the drawing before commencing work.
- 2) Any discrepancies observed on this drawing issued by any other party are to be immediately brought to consultant Architect Notice.
- 3) All dimension are in millimeter.
- 4) Dimension are to be confirmed on site.

Client :-

MR. ADEBAYO
OLUWATOBI ABIODUN

Location :-

ON DUROSUSU FAMILY LAND
ALONG EGAN ROAD MOJODA ODO
AYAN
EPE LOCAL GOVT AREA,
LAGOS STATE.

Project Title :-

As-Built Residential
Development

Approval
Drawing

Architect :-

YUNGOLA SERVICES
LTD.

(ARCHITECTURAL DESIGN, STRUCTURAL DESIGN,
CONSULTANT,SUPERVISION)

OFFICE ADDRESS:

NO 2 OSHOGBO STREET,
OGUDU
LAGOS STATE
TEL ; 08054178584, 07062539641

Office stamp

sheet
content:-

Plan

date :-

sheet no :-

scale :-

1:100

revision :-

Drawn by :-

Yungola


Checked by :-

Oluwaseun





OCTOBER, 2024

NOTE;

WINDOWS SCHEDULE

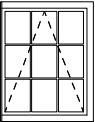WINDOWS SCHEDULE				
PROFILE				
LABEL ON PLAN	W1	W2	W3	
NO'S REQD	8	1	3	
DESCRIPTION	Aluminum casement windows with burglary bars, fly and mosquito screen			
DIMENSION (MM)	1200 X 1200	600 X 1200	600 X 600	

DOORS SCHEDULE

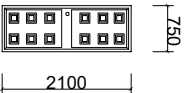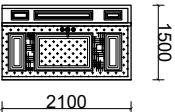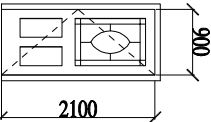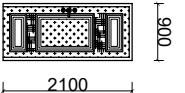PROFILE				
LABEL ON PLAN	D1	D2	D3	D4
NO'S REQD	2	1	4	1
DESCRIPTION	Single action, single leaf steel panel door with steel frame see manufacturers fixing catalogue for details.	Single action, single leaf steel panel door with steel frame see manufacturers fixing catalogue for details.	Single action, single leaf steel panel door with steel frame see manufacturers fixing catalogue for details.	Single action, single leaf steel panel door with steel frame see manufacturers fixing catalogue for details.
DIMENSION (MM)	750 X 2100	1500 X 2100	900 X 2100	900 X 2100

SCHEDULE

general note

1) The contractor is to check all the drawing before commencing work.
2) Any discrepancies observed on this drawing issued by any other party are to be immediately brought to consultant Architect Notice.
3) All dimension are in millimeter.
4) Dimension are to be confirmed on site.

Client :-
MR. ADEBAYO OLUWATOBI ABIODUN

Location :-
ON DUROSUSU FAMILY LAND
ALONG EGAN ROAD MOJODA ODO
AYAN
EPE LOCAL GOVT AREA,
LAGOS STATE.

Project Title :-
As-Built Residential Development

Architect :-
YUNGOLA SERVICES LTD.
(ARCHITECTURAL DESIGN, STRUCTURAL DESIGN, CONSULTANT,SUPERVISION)

OFFICE ADDRESS:
NO 2 OSHOGBO STREET,
OGUDU
LAGOS STATE
☎️ ; 08054178584, 07062539641

Office stamp


sheet content:-
Plan

date :-
OCTOBER, 2024

sheet no :-
scale :-
1:100

revision :-
Drawn by :-
Yungola
Checked by :-
Oluwaseun

NOTE;

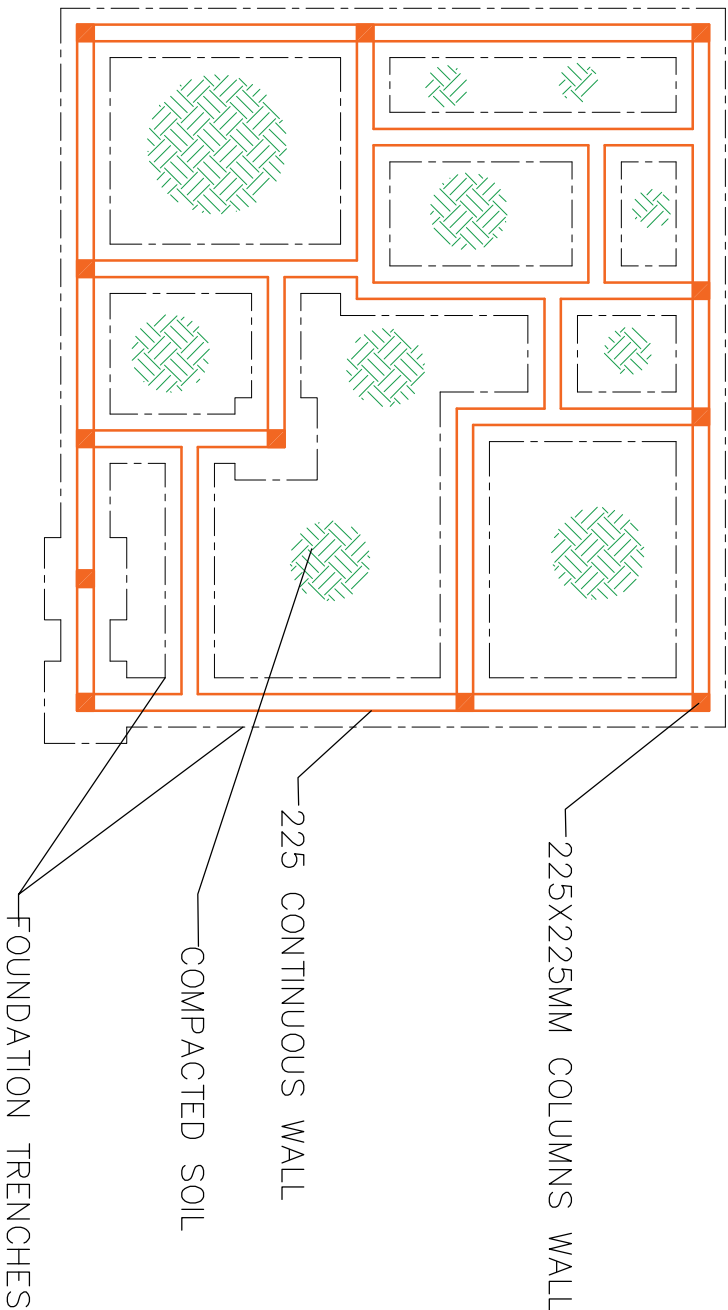

EXISTING FOUNDATION FOOTING/PLAN

general note

- 1) The contractor is to check all the drawing before commencing work.
- 2) Any discrepancies observed on this drawing issued by any other party are to be immediately brought to consultant Architect Notice.
- 3) All dimension are in millimeter.
- 4) Dimension are to be confirmed on site.

Client :-

**MR. ADEBAYO
OLUWATOBI ABIODUN**

Location :-

ON DUROSUSU FAMILY LAND
ALONG EGAN ROAD MOJODA ODO
AYAN
EPE LOCAL GOVT AREA,
LAGOS STATE.

Project Title :-

**As-Built Residential
Development**

Approval
Drawing

Architect :-

**YUNGOLA SERVICES
LTD.**

(ARCHITECTURAL DESIGN, STRUCTURAL DESIGN,
CONSULTANT,SUPERVISION)

OFFICE ADDRESS:

NO 2 OSHOGBO STREET,
OGUDU
LAGOS STATE
TEL ; 08054178584, 07062539641

Office stamp

sheet
content:-

Plan

date :-

OCTOBER, 2024

sheet no :-

scale :-

1:100

revision :-

Drawn by :-

Yungola


Checked by :-

Oluwaseun

NOTE:

DETAILS





TYPICAL SOAKAWAY AND SEPTIC TANK DETAILS

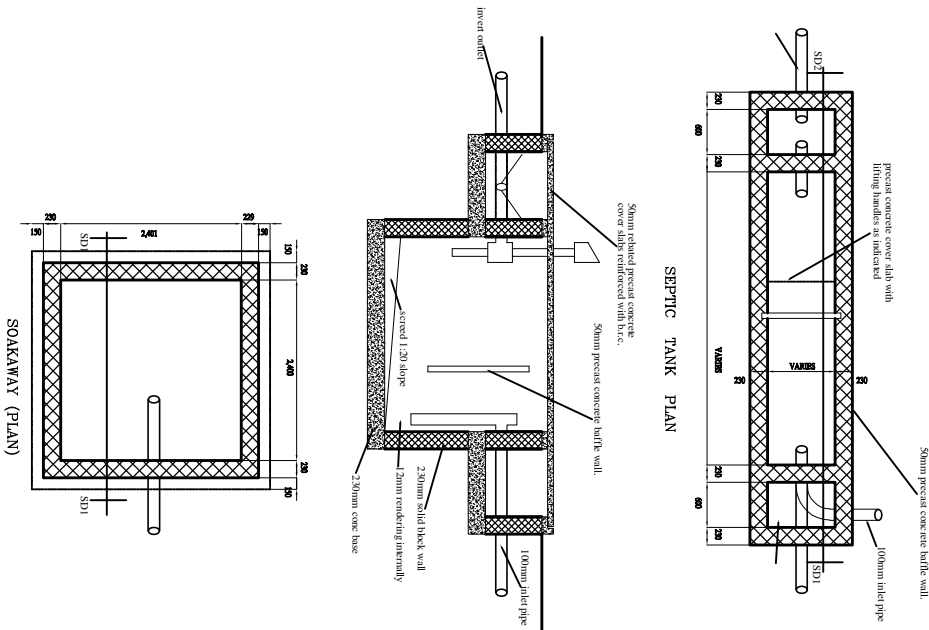

1	2	3	4	5	6	7	8	9	10
TANK TYPE	NO. of users	Capacity of TANK	Length	Height	Depth	Outlet	Dist. to	Average	
A	10	0.187	1.1820	2400	600	1275	1200	900	1800
B	15	0.088	1.470	2775	825	1275	1200	1125	1800
C	20	0.084	1.680	3000	1050	1350	1275	1200	1800
D	50	0.070	3.500	3600	1200	1575	1500	1500	1800
E	100	0.070	7.000	4800	1950	1650	1575	2100	1800
F	200	0.070	14.000	6000	2450	1875	1800	2700	1800

TYPICAL SECTION THROUGH LINTEL

LINTEL SCHEDULE									
CLEAR SPAN	DEPTH	WIDTH	PTM BAR/ TOP BAR	LINKS					
000-1500	225	225	S-Y12	S-Y12	Y10-250c/c				
1500-1800	225	225	S-Y12	S-Y12	Y10-250c/c				
1800-2400	300	225	S-Y12	S-Y12	Y10-250c/c				
2400-3000	300	225	S-Y12	S-Y12	Y10-250c/c				

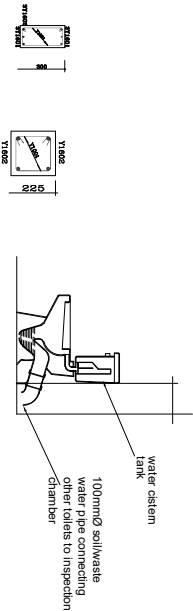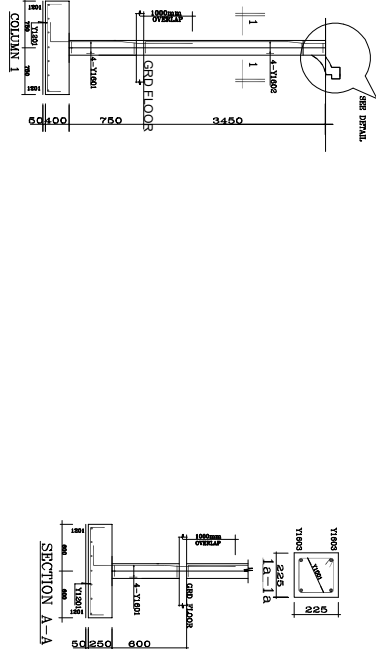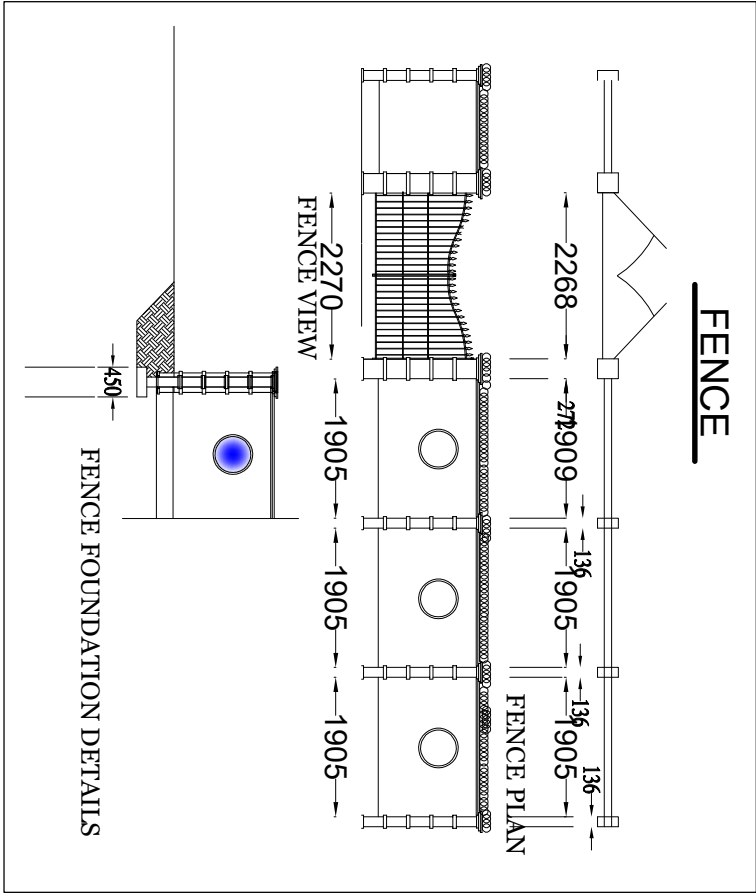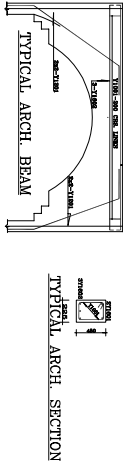

general note

- 1) The contractor is to check all the drawing before commencing work.
- 2) Any discrepancies observed on this drawing issued by any other party are to be immediately brought to consultant Architect Notice.
- 3) All dimension are in millimeter.
- 4) Dimension are to be confirmed on site.

Client :-

MR. ADEBAYO OLUWATOBI ABIODUN

Location :-

ON DUROSUSU FAMILY LAND
ALONG EGAN ROAD MOJODA ODO
AYAN
EPE LOCAL GOVT AREA,
LAGOS STATE.

Project Title :-

As-Built Residential Development

Approval
Drawing

Architect :-


YUNGOLA SERVICES LTD.

(ARCHITECTURAL DESIGN, STRUCTURAL DESIGN,
CONSULTANT,SUPERVISION)

OFFICE ADDRESS:

NO 2 OSHOGBO STREET,
OGUDU
LAGOS STATE
☎ ; 08054178584, 07062539641

Office stamp

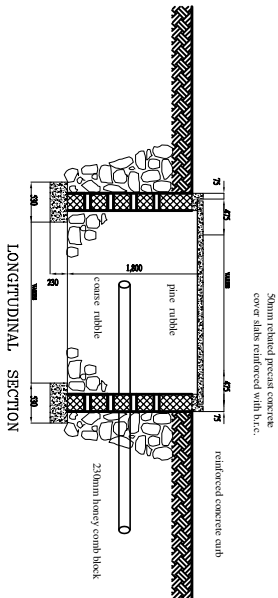

sheet content:-
Plan

sheet no :-

date :-

scale :-
1:100

revision :-

OCTOBER, 2024

Drawn by :-
Yungola
Checked by :-
Oluwaseun